

K 2048

10-4-63

WATER WELL DRILLERS LOG

K

Date: 10-4, 1963, Driller: Sutter Well Dr Co County Hancock (Name)

(1) Owner of Land: C W Jregle (Name) 8800 Opricot St. N.O. La. (Address)

(2) Location: SE 1/4, NE 1/4, Sec. 6 T 95R 14W 5 miles W of Bay St Louis (distance) (direction) (Nearest Town)

(3) Topography: flat (Hilly) (Flat) (Level)

(4) Purpose of Well: domestic HOME (Domestic Irrigation Municipal, Industrial, Other)

Description & Color of Materials Sand, Clay, Red Clay, Shell, etc.

Thick-ness Feet

Depth Feet

sand 71 71

Clay 21 92

sand 13 105

sand & gravel 21 126

Information upon completion of well:

(1) Diameter 2 inches.

(2) Total Depth 126 feet.

(3) Water Level 8 feet below top of ground.

(4) Cased to 121 ft, Size 2"


(5) Screen: Size 2", Length 5'

(6) Were any formations sealed against pollution? yes, no.

If YES depth of formation

Why

Drillers Remarks:

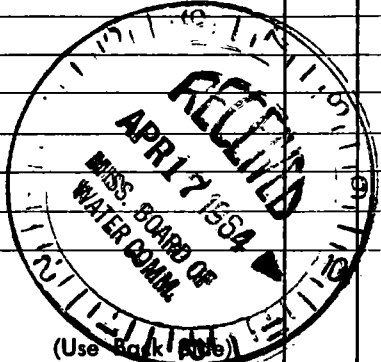

Well No.

(Use back side)

2