

K 2049

10-19-63

WATER WELL DRILLERS LOG

Date: 10/19, 1963, Driller: Intex Well Works County Hancock

(Name)

(1) Owner of Land: Sam Whitfield
(Name)

Bay St. Louis, Miss.
(Address) Town

(2) Location: 1/4, 1/4, Sec. T 2R 14

1/2 miles N of Bay St. Louis
(distance) (direction) (Nearest Town)

(3) Topography: Hilly
(Hilly) (Flat) (Level)

(4) Purpose of Well: irrigation
(Domestic Irrigation
Municipal, Industrial, Other)

Description & Color of Materials
Sand, Clay, Red Clay, Shell, etc.

Thick-
ness
Feet

Depth
Feet

Surface sand	14	14
Clay	48	62
sand	62	124
Clay	24	148
sand	63	211

(general in last 20')

Information upon completion of well:

(1) Diameter 2 x 3 inches.

(2) Total Depth 211 feet.

(3) Water Level 14 feet below top of ground.

(4) Cased to 196 Top 126' of 3"
4", Size 2"


(5) Screen: Size 2", Length 15'

(6) Were any formations sealed against pollution?
yes, no.

If YES depth of formation _____

Why _____

Drillers Remarks: _____

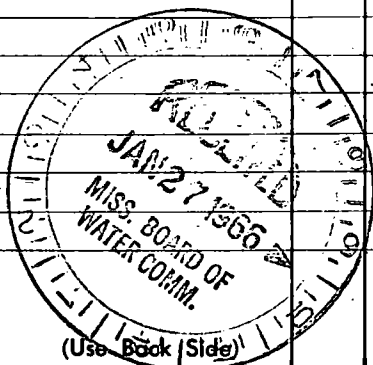

Well No. _____

Handwritten text at the top of the page, possibly a title or header.

Main body of handwritten text, appearing to be a list or series of entries.

500

100

50

Handwritten text in the lower middle section.

200

Handwritten text in the lower section.

100

50

100

50

100

50

100