

K 2050

11-6-63

WATER WELL DRILLERS LOG

K

Date: 11-6, 1963, Driller: Sutter Well Drilling Co. County Hancock

(Name)

(1) Owner of Land: Robert Epperson  
(Name)

Rt. 2, Box 431 - Bay St. Louis, Miss.  
(Address)

(2) Location: SW 1/4, NE 1/4, Sec. 30 T. 25 R. 14 W.

3 miles W of Bay St. Louis  
(distance) (direction) (Nearest Town)

(3) Topography: flat  
(Hilly) (Flat) (Level)

(4) Purpose of Well: domestic home  
(Domestic Irrigation, Municipal, Industrial, Other)

Information upon completion of well:

(1) Diameter 2 inches.

(2) Total Depth 110 feet.

(3) Water Level 4 feet below top of ground.

(4) Cased to 105' g.c., Size 2"

(5) Screen: Size 2", Length 5'

(6) Were any formations sealed against pollution?


yes, no.

If YES depth of formation

Why

Drillers Remarks:

Description & Color of Materials Sand, Clay, Red Clay, Shell, etc.	Thick- ness Feet	Depth Feet
Clay	18	18
Sand	17	35
Clay	52	87
Sand	23	110

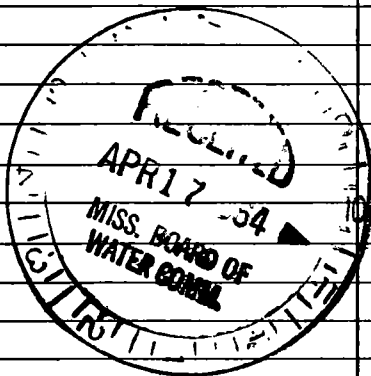

(Use Back Side)

Well No.

Handwritten header text, possibly a title or date, located at the top of the page.

Main body of handwritten text, consisting of several lines of cursive script.

Second section of handwritten text, appearing as a separate paragraph or entry.

Final section of handwritten text at the bottom of the page, possibly a signature or conclusion.