

K 7052

11-20-63

WATER WELL DRILLERS LOG

K

Date: 11-20, 1963, Driller: Sutton Well Works County Hancock
 (Name)

(1) Owner of Land: Vernon Slavich
 (Name)
208 Livingston Ave. - Arabi La.
 (Address)
 (2) Location: NE 1/4, NE 1/4, Sec. 22, T8S R14W
2 miles NW of Bay St. Louis
 (distance) (direction) (Nearest Town)
 (3) Topography: flat
 (Hilly) (Flat) (Level)
 (4) Purpose of Well: domestic home
 (Domestic Irrigation
 Municipal, Industrial, Other)


Description & Color of Materials Sand, Clay, Red Clay, Shell, etc.	Thick- ness Feet	Depth Feet
Clay	18	18
sand	17	35
Clay	83	118
soft clay, sand	37	155
Clay	125	280
sand	8	288

Information upon completion of well:

(1) Diameter 2 inches.
 (2) Total Depth 388 feet. FID
 (3) Water Level 6" above 283 feet below top of ground.
 (4) Cased to set, Size 2"
 (5) Screen: Size 2", Length 5'
 (6) Were any formations sealed against pollution?
 _____ yes, no.

If YES depth of formation _____
 Why _____

Drillers Remarks: _____

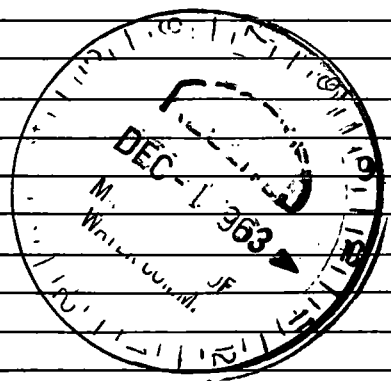

(Use Back Side)

Well No.

