

K 2683

WATER WELL DRILLERS LOG

K

11-25-63

Date: 11-25, 1963, Driller: Sutter Well Works County Hancock
 (Name)

(1) Owner of Land: J.A. Mayeant
 (Name)
2514 Bayou Rd - N.O. La.
 (Address)

(2) Location: NE 1/4, SW 1/4, Sec. 40 T85R14W
5 miles NW of Bay St Louis
 (distance) (direction) (Nearest Town)

(3) Topography: flat
 (Hilly) (Flat) (Level)

(4) Purpose of Well: domestic Home
 (Domestic Irrigation
 Municipal, Industrial, Other)

| Description & Color of Materials Sand, Clay, Red Clay, Shell, etc. | Thick- ness Feet | Depth Feet |
|---|------------------------|---------------|
| <u>Sand</u> | <u>30</u> | <u>30</u> |
| <u>Sand-clay streaks</u> | <u>59</u> | <u>89</u> |
| <u>clay</u> | <u>45</u> | <u>134</u> |
| <u>sand</u> | <u>21</u> | <u>155</u> |

Information upon completion of well:

(1) Diameter 2 inches.

(2) Total Depth 155 feet.

(3) Water Level 2 feet below top of ground.
150

(4) Cased to cell, Size 2"


(5) Screen: Size 2", Length 5'

(6) Were any formations sealed against pollution?
no.

If YES depth of formation _____

Why _____

Drillers Remarks: _____

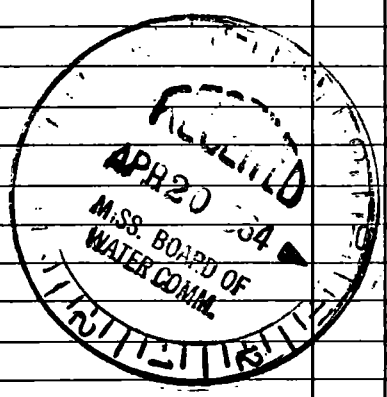

Well No.

(Use Back Side)

Handwritten text at the top of the page, possibly a title or header.

11-22

Handwritten notes on the right side of the page, including the number 128.

Small handwritten notes on the left side of the page.

Handwritten notes in the middle section of the page.

128

Handwritten mark or signature.

Handwritten mark or signature.