

K 7056

WATER WELL DRILLERS LOG

K

1-14-64

Date: 1-14-, 1964, Driller: Butter Well Works County Hancock

(Name)

(1) Owner of Land: H. Nelson

(Name)

Logtown, Mississippi

(Address)

(2) Location: SW 1/4, SW 1/4, Sec. 36 T85R14, E0

1 miles W, of Baylors

(distance)

(direction)

(Nearest Town)

(3) Topography: flat

(Hilly)

(Flat)

(Level)

(4) Purpose of Well: domestic home

(Domestic Irrigation
Municipal, Industrial, Other)

Description & Color of Materials
Sand, Clay, Red Clay, Shell, etc.

Thick-
ness
Feet

Depth
Feet

Sand

70

70

Clay

18

88

Sand

43

131

Information upon completion of well:

(1) Diameter 2 inches.

(2) Total Depth 131 feet.

(3) Water Level 19 feet below top of ground.

(4) Cased to all, Size 2"

(5) Screen: Size 2", Length 5'


(6) Were any formations sealed against pollution?

no

If YES depth of formation _____


Why _____

Drillers Remarks: _____

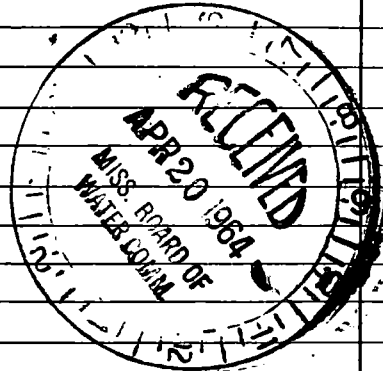

(Use Back Side)

Well No.

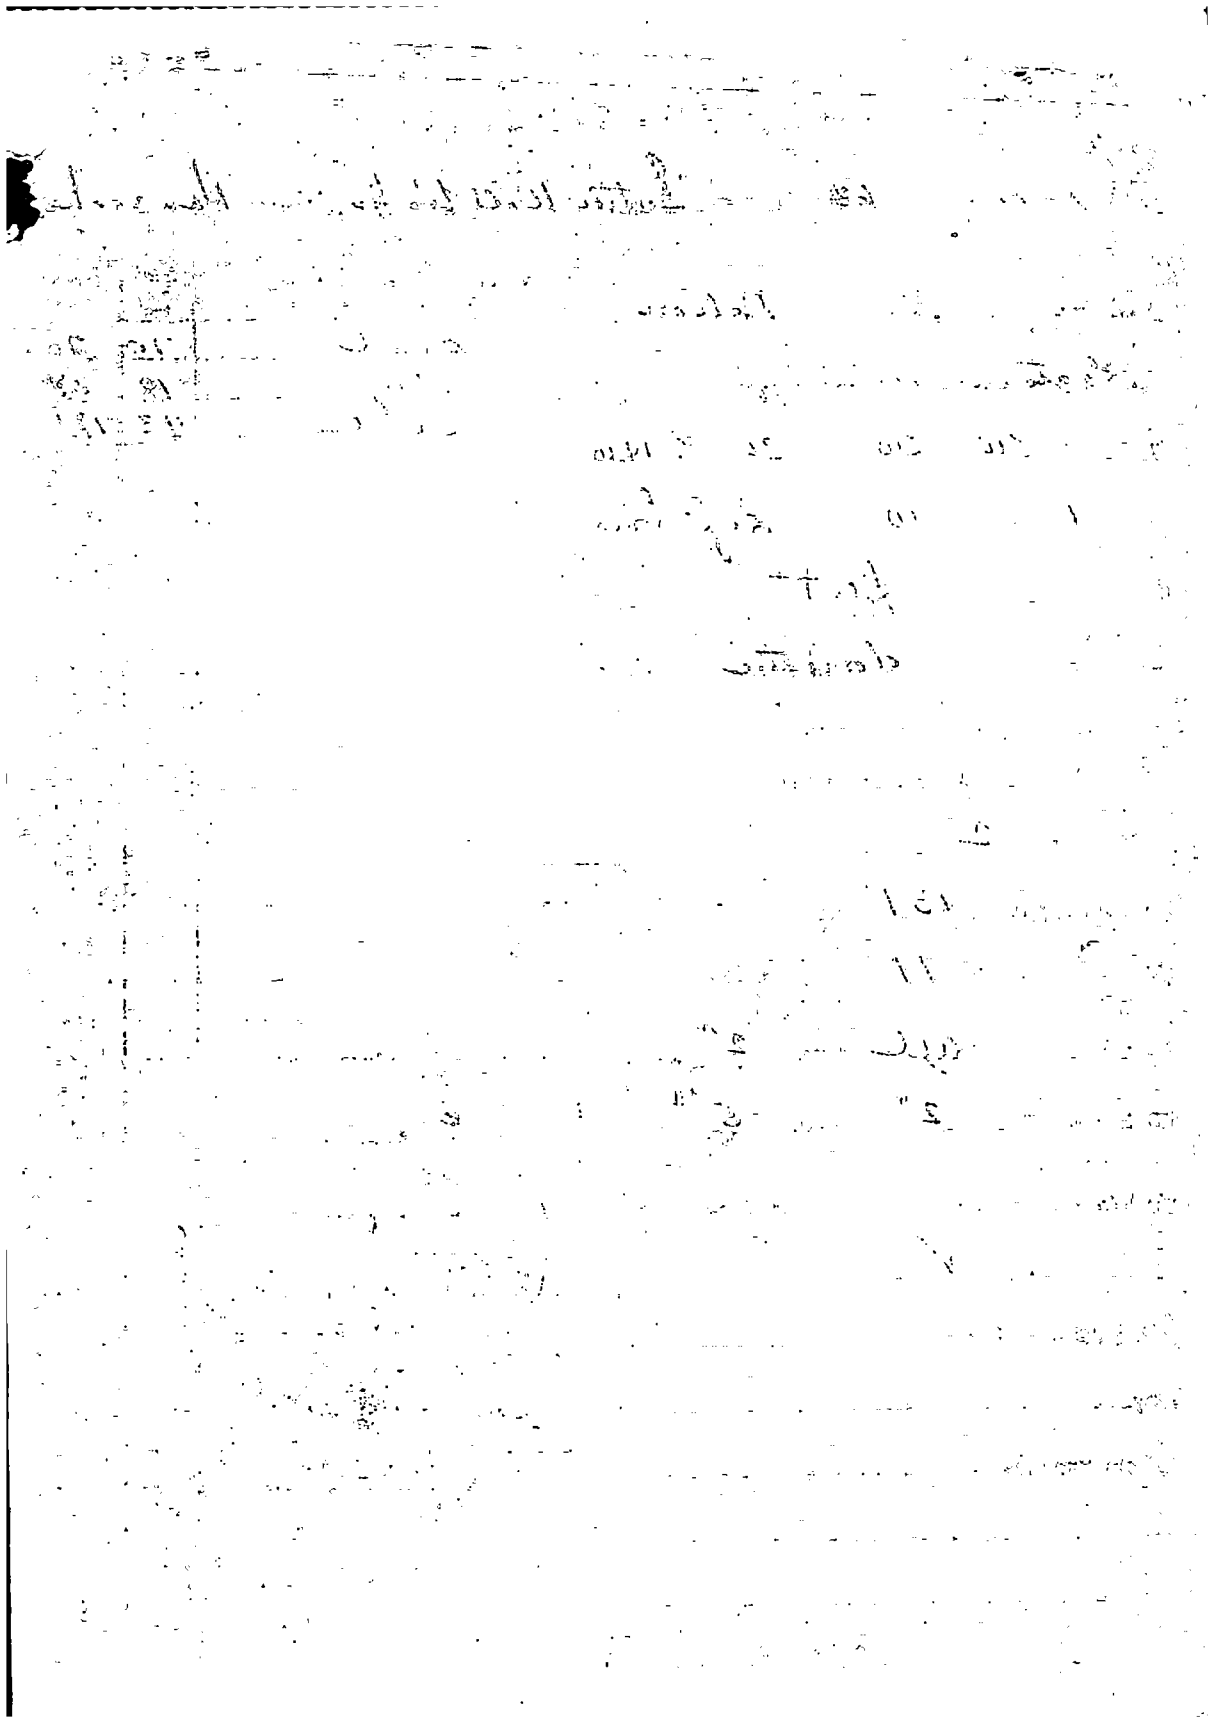

Lecture 10

Lecture

10 11 12

10 11 12

