

K 2057

2-21-64

WATER WELL DRILLERS LOG

K

Date: 2-21, 1964, Driller: Sutter Well Works County Hancock

(Name)

(1) Owner of Land: Frank Corso

(Name)

Bay St Louis, Miss.

(Address)

(2) Location: 1/4, 1/4, Sec. T8SR 14W

miles (distance)

1.4 miles NW Bay St Louis (direction) (Nearest Town)

(3) Topography: flat (Hilly) (Flat) (Level)

(4) Purpose of Well: domestic home (Domestic Irrigation Municipal, Industrial, Other)

Information upon completion of well:

(1) Diameter 2 inches.

(2) Total Depth 131 feet.

(3) Water Level 14 feet below top of ground.

(4) Cased to 124 feet, Size 2"

(5) Screen: Size 2", Length 5'

(6) Were any formations sealed against pollution?

yes, no.

If YES depth of formation

Why


Drillers Remarks:

Description & Color of Materials Sand, Clay, Red Clay, Shell, etc.

Thick-ness Feet

Depth Feet

Clay	18	18
sand	26	44
Clay	24	68
sand	63	131

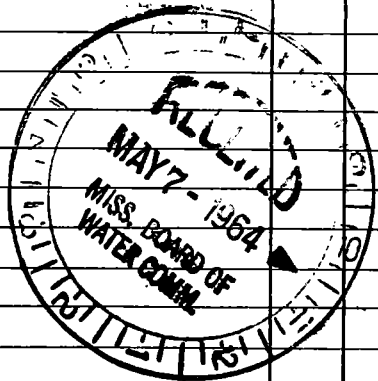

(Use Back Side)

Well No.

Handwritten text at the top of the page, possibly a header or title, which is mostly illegible due to fading and noise.

A block of handwritten text on the left side of the page, containing several lines of illegible script.

Handwritten text in the upper right quadrant, appearing to be a list or set of notes.

Handwritten text in the middle right section, possibly a continuation of the notes or a separate entry.

Handwritten text in the lower right quadrant, including what appears to be a signature or a date.

The bottom half of the page contains several lines of handwritten text, which are very faint and difficult to decipher.