

K 2058

4-13-64

WATER WELL DRILLERS LOG

K

Date: 4-13, 1964, Driller: Sutter Well Works County Hancock

(Name)

(1) Owner of Land: F. J. Shindler
(Name)
7845 Jay St - Metairie
(Address)

(2) Location: NE 1/4, SW 1/4, Sec. 39 T. 85 R. 14 W
5 miles NW, of Bay St Louis
(distance) (direction) (Nearest Town)

(3) Topography: flat
(Hilly) (Flat) (Level)

(4) Purpose of Well: domestic home
(Domestic Irrigation
 Municipal, Industrial, Other)

Description & Color of Materials Sand, Clay, Red Clay, Shell, etc.	Thick- ness Feet	Depth Feet
<u>Clay</u>	<u>15</u>	<u>15</u>
<u>Sand</u>	<u>30</u>	<u>45</u>
<u>Clay</u>	<u>45</u>	<u>90</u>
<u>Sand</u>	<u>40</u>	<u>130</u>

Information upon completion of well:

(1) Diameter 2 inches.

(2) Total Depth 130 feet. Flow

(3) Water Level 1/2 feet above top of ground.

(4) Cased to gall, Size 2"


(5) Screen: Size 2", Length 5'

(6) Were any formations sealed against pollution?
 _____ yes, no.

If YES depth of formation _____

Why _____

Drillers Remarks: _____

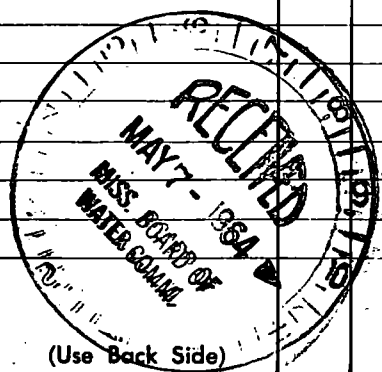

Well No.

(Use Back Side)

Handwritten header text, possibly a title or date, located at the top of the page.

Handwritten text in the upper middle section, appearing to be a list or series of notes.

Handwritten text in the middle section, continuing the list or notes.

Handwritten text in the lower middle section, possibly including a signature or a specific entry.

Handwritten text in the bottom section, which appears to be a concluding paragraph or a separate note.