

K 2059
4-14-64

K

WATER WELL DRILLERS LOG

Date: 4-14, 1964, Driller: Sutter Well Works County Hancock
(Name)

	Description & Color of Materials Sand, Clay, Red Clay, Shell, etc.	Thick- ness Feet	Depth Feet
(1) Owner of Land: Dudley Gregory (Name) Bay St. Louis, Miss (Address)	Previous well	120	120
	Clay	210	330
(2) Location: NW 1/4, SE 1/4, Sec. 35 T 85 R 14 W	Sand streaks	46	376
	Sand	17	393
1 miles W of Bay St. Louis (distance) (direction) (Nearest Town)			
(3) Topography: flat (Hilly) (Flat) (Level)			
(4) Purpose of Well: Domestic Homes (Domestic Irrigation Municipal, Industrial, Other)			


Information upon completion of well:

- (1) Diameter 2 inches.
- (2) Total Depth 393 feet.
- (3) Water Level 3 feet below top of ground. 383
- (4) Cased to top, Size 2"
- (5) Screen: Size 2", Length 10'
- (6) Were any formations sealed against pollution?
yes, no.

If YES depth of formation _____

Why _____

Drillers Remarks: _____

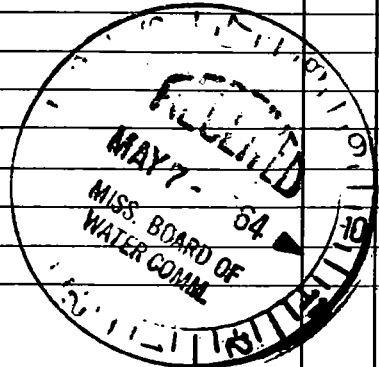

(Use Back Side)

Well No.

Handwritten notes at the top of the page, including the word "Biology" and other illegible scribbles.

Handwritten notes in the middle section, possibly including the word "Tissue" and other illegible text.

Handwritten notes in the lower middle section, including the word "Structure" and other illegible text.

Handwritten notes at the bottom of the page, including the word "Function" and other illegible text.