

K ~~2060~~ ~~2079~~

WATER WELL DRILLERS LOG

K

4-17-64 K2060

Date: 4-17, 1964, Driller: Sutter Well Works County Hancock

(Name)

(1) Owner of Land: Mrs John Amos, Sr
(Name)
5230 St Roch - New Orleans
(Address)

(2) Location: SE 1/4, NW 1/4, Sec 29 T85R14W
4 miles NW, of Bay St Louis
(distance) (direction) (Nearest Town)

(3) Topography: flat
(Hilly) (Flat) (Level)

(4) Purpose of Well: domestic home
(Domestic Irrigation, Municipal, Industrial, Other)

Description & Color of Materials Sand, Clay, Red Clay, Shell, etc.	Thick- ness Feet	Depth Feet
Clay	10	10
sand	45	55
Clay	35	90
fine sand	40	130
Clay	10	140
sand	32	172

Information upon completion of well:

(1) Diameter 1 1/4 inches.

(2) Total Depth 172 feet.

(3) Water Level 1/2 feet below top of ground. ^{above} FLOW

(4) Cased to 167, Size 1 1/4"

(5) Screen: Size 1 1/2", Length 5'


(6) Were any formations sealed against pollution?

yes, no.

If YES depth of formation _____

Why _____

Drillers Remarks: _____

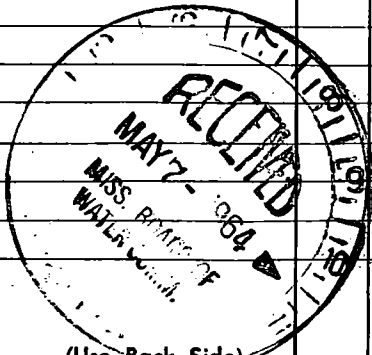

(Use Back Side)

Well No.

