

K 2062
5-4-64

WATER WELL DRILLERS LOG

K

Date: 5-4, 1964, Driller: Lutter Well Works County Hancock
(Name)

- (1) Owner of Land: A. J. Blakesley
(Name)
624 Helpe Ave., N.O. 20, La.
(Address)
- (2) Location: SE 1/4, NW 1/4, Sec. 37 T85 R14, W
3 miles W of Bay St Louis
(distance) (direction) (Nearest Town)
- (3) Topography: flat
(Hilly) (Flat) (Level)
- (4) Purpose of Well: domestic home
(Domestic Irrigation, Municipal, Industrial, Other)


Description & Color of Materials Sand, Clay, Red Clay, Shell, etc.	Thick- ness Feet	Depth Feet
Mud & Clay	15	15
sand	20	35
Clay	70	105
sand	67	172
Clay	81	253
sand	40	293

Information upon completion of well:

- (1) Diameter 2 inches.
- (2) Total Depth 293 feet.
- (3) Water Level 2 feet above flow below top of ground. 288
- (4) Cased to top, Size 2"
- (5) Screen: Size 2", Length 5'
- (6) Were any formations sealed against pollution?
 yes, no.

If YES depth of formation _____
Why _____

Drillers Remarks: _____

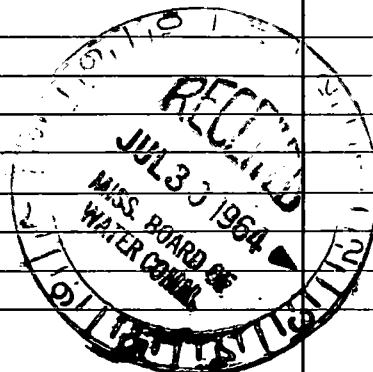

(Use Back Side)

Well No.

Handwritten header text, possibly a title or date, located at the top of the page.

Main body of handwritten text, appearing as several lines of cursive script.

A specific handwritten phrase or signature located in the middle-right section of the page.

A small handwritten mark or signature located in the lower-right quadrant.

Handwritten text located in the lower-middle section of the page, possibly a signature or a note.

Handwritten text located at the bottom right of the page.

Handwritten text located at the bottom right of the page, below the previous line.