

K 2064  
5-18-64

WATER WELL DRILLERS LOG

K

Date: 5-18-, 1964, Driller: Sutter Well Works County Harrison <sup>Hancock</sup>

(Name)

(1) Owner of Land: James Roberts  
(Name)  
Pass Christian, Miss  
(Address)

(2) Location: NE 1/4, NE 1/4, Sec. 33 T8S R14W  
5 miles NW of Bay St Louis  
(distance) (direction) (Nearest Town)

(3) Topography: flat  
(Hilly) (Flat) (Level)

(4) Purpose of Well: Domestic Home  
(Domestic Irrigation  
Municipal, Industrial, Other)

Description & Color of Materials Sand, Clay, Red Clay, Shell, etc.	Thick- ness Feet	Depth Feet
<u>clay</u>	<u>18</u>	<u>18</u>
<u>sand</u>	<u>29</u>	<u>47</u>
<u>clay</u>	<u>51</u>	<u>98</u>
<u>sand</u>	<u>34</u>	<u>132</u>

Information upon completion of well:

(1) Diameter 2 inches.

(2) Total Depth 132 feet.

(3) Water Level 3 feet below top of ground.

(4) Cased to 127, Size 2"


(5) Screen: Size 2, Length 5'

(6) Were any formations sealed against pollution?  
no yes,  no.

If YES depth of formation \_\_\_\_\_

Why \_\_\_\_\_

Drillers Remarks: \_\_\_\_\_

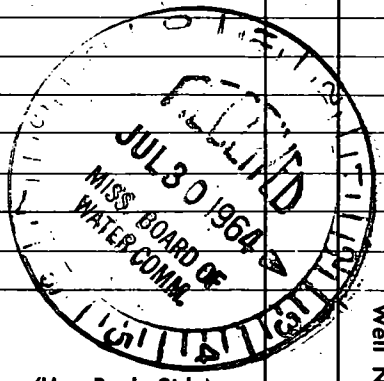

Well No.

(Use Back Side)

