

K 2065
5-26-64

WATER WELL DRILLERS LOG

K

Date: 5-26, 1964, Driller: Sutter Well Works County Hancock
(Name)


(1) Owner of Land: <u>Les Beir, Jr.</u> (Name)	Description & Color of Materials Sand, Clay, Red Clay, Shell, etc.	Thick- ness Feet	Depth Feet
<u>2619 Lafayette St., Hattiesburg</u> (Address)	Clay	9	9
(2) Location: <u>SW 1/4, NE 1/4, Sec 42 T85R14, W</u>	sand	21	30
<u>3</u> miles <u>W</u> , of <u>Bay St Louis</u> (distance) (direction) (Nearest Town)	clay	15	45
(3) Topography: <u>flat</u> (Hilly) (Flat) (Level)	sand	29	74
(4) Purpose of Well: <u>domestic Home</u> (Domestic Irrigation Municipal, Industrial, Other)			

Information upon completion of well:

- (1) Diameter 2 inches.
- (2) Total Depth 74 feet.
- (3) Water Level 8 feet below top of ground.
- (4) Cased to 69' / 2 1/2', Size 2"
- (5) Screen: Size 2", Length 5'
- (6) Were any formations sealed against pollution?
 yes, no.

If YES depth of formation surface
Why _____

Drillers Remarks: _____

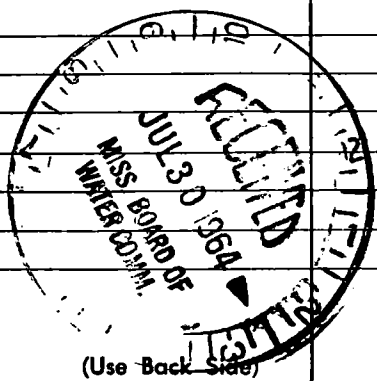

Well No.

(Use Back Side)

1. 1000 1000 1000 1000 1000 1000 1000 1000 1000 1000

2. 1000 1000 1000 1000 1000 1000 1000 1000 1000 1000

3. 1000 1000 1000 1000 1000 1000 1000 1000 1000 1000

4. 1000 1000 1000 1000 1000 1000 1000 1000 1000 1000

5. 1000 1000 1000 1000 1000 1000 1000 1000 1000 1000

6. 1000 1000 1000 1000 1000 1000 1000 1000 1000 1000

7. 1000 1000 1000 1000 1000 1000 1000 1000 1000 1000

8. 1000 1000 1000 1000 1000 1000 1000 1000 1000 1000