

K 2066

5-27-64

WATER WELL DRILLERS LOG

Date: 5-27, 1964, Driller: Butter Wee Wee County Hancock

(Name)

(1) Owner of Land: Harry Crase
(Name)

108 Carmel Ave - Bay St Louis
(Address)

(2) Location: NW 1/4, NW 1/4, Sec. 46 T85R14, W

3 miles W; of Bay St Louis
(distance) (direction) (Nearest Town)

(3) Topography: flat
(Hilly) (Flat) (Level)

(4) Purpose of Well: domestic Home
(Domestic Irrigation
Municipal, Industrial, Other)

Description & Color of Materials
Sand, Clay, Red Clay, Shell, etc.

Thick-
ness
Feet

Depth
Feet

| | | |
|-----------------------|------------|------------|
| <u>Sand & mud</u> | <u>30</u> | <u>30</u> |
| <u>blue clay</u> | <u>102</u> | <u>132</u> |
| <u>fine sand</u> | <u>23</u> | <u>155</u> |

Information upon completion of well:

(1) Diameter 2 inches.

(2) Total Depth 155 feet.

(3) Water Level 2 feet below top of ground.

(4) Cased to app, Size 2"

(5) Screen: Size 2", Length 5'


(6) Were any formations sealed against pollution?

yes, no.

If YES depth of formation surface

Why

Drillers Remarks:

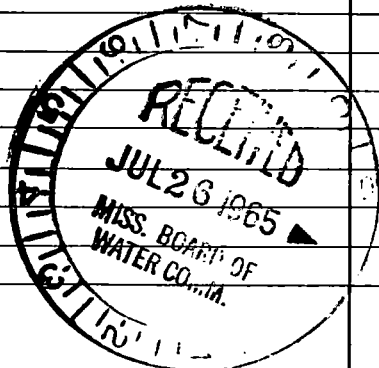

(Use Back Side)

Well No.

Handwritten text at the top of the page, possibly a header or title, which is mostly illegible due to the quality of the scan.

Handwritten text in the upper middle section of the page, appearing to be a list or a series of notes.

Handwritten text in the middle section of the page, continuing the list or notes.

Handwritten text in the lower middle section of the page, possibly a summary or conclusion.

Handwritten text at the bottom of the page, which may include a signature or a date.