

K 2067

WATER WELL DRILLERS LOG

K

5-29-64

Date: 5-29, 1964, Driller: Sutter Well Works County Hancock

(Name)

(1) Owner of Land: Era Johnson
(Name)

Rt 1, Box 338 Bay St Louis, Miss.
(Address)

(2) Location: NE 1/4, NE 1/4, Sec. 33 T85R14, W

5 miles W of Bay St Louis
(distance) (direction) (Nearest Town)

(3) Topography: flat
(Hilly) (Flat) (Level)

(4) Purpose of Well: domestic home
(Domestic Irrigation
Municipal, Industrial, Other)

Description & Color of Materials
Sand, Clay, Red Clay, Shell, etc.

Thick-
ness
Feet

Depth
Feet

clay

15

15

sand

20

35

clay

93

128

sand

12

140

Information upon completion of well:

(1) Diameter 2 inches.

(2) Total Depth 140 feet.

(3) Water Level 5 feet below top of ground.

(4) Cased to all, Size 2"

(5) Screen: Size 2", Length 5'


(6) Were any formations sealed against pollution?

yes, no.

If YES depth of formation surface

Why

Drillers Remarks:

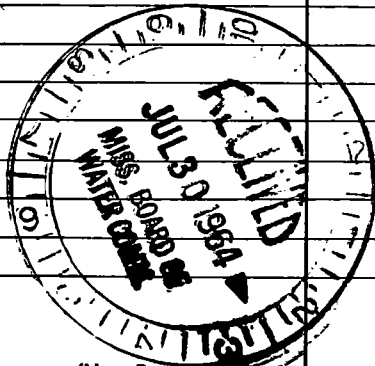

(Use Back Side)

Well No.

12-15-1911

W. H. R. Co.

100

100

221	700	1000
113	600	1000
100	100	1000
100	100	1000

W. H. R. Co.

100

100

