

HANCOCK

K 2068 WATER WELL DRILLERS LOG

K

6-3-64

Date: 6-3-, 1964, Driller: Sutton Well Works County Hancock

(Name)

(1) Owner of Land: James Cooley
(Name)
Bay St. Louis, Miss
(Address)

Description & Color of Materials
Sand, Clay, Red Clay, Shell, etc.

Thick-
ness
Feet

Depth
Feet

clay	15	15
sand	20	35
clay	100	135
sand	44	179

(2) Location: SE 1/4, NW 1/4, Sec. 47 T85R14W
5 miles W, of Bay St Louis
(distance) (direction) (Nearest Town)

(3) Topography: flat
(Hilly) (Flat) (Level)


(4) Purpose of Well: domestic home
(Domestic Irrigation
Municipal, Industrial, Other)

Information upon completion of well:

- (1) Diameter 2 inches.
- (2) Total Depth 179 feet.
- (3) Water Level 2 feet below top of ground.
- (4) Cased to agl, Size 2"
- (5) Screen: Size 2", Length 5'
- (6) Were any formations sealed against pollution?
no.

If YES depth of formation _____
Why _____

Drillers Remarks: _____

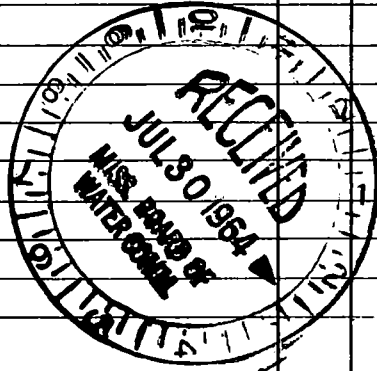

(Use Back Side)

Well No.

Handwritten header text, possibly a title or address, located at the top of the page.

Handwritten text in the upper middle section, appearing to be a list or series of notes.

Handwritten text in the middle section, continuing the list or notes.

Handwritten text in the lower middle section, possibly a summary or conclusion.

Handwritten text at the bottom of the page, including what appears to be a signature or date.