

K 2070
6-10-64

WATER WELL DRILLERS LOG

K

Date: 6-10, 1964, Driller: Little Well Works County Hancock
(Name)

(1) Owner of Land: <u>E. H. TABLE</u> <small>(Name)</small> <u>1026 Brooklyn Ave. N.O.La.</u> <small>(Address)</small>	Description & Color of Materials Sand, Clay, Red Clay, Shell, etc.	Thick- ness Feet	Depth Feet
	Clay	15	15
	sand	17	32
	Clay	24	56
	sand	8	64
	Clay	58	132
	sand	31	163

(2) Location: SW 1/4, NE 1/4, Sec. 47 T8S R 14W
5 miles N of Bay St Louis
(distance) (direction) (Nearest Town)

(3) Topography: flat
(Hilly) (Flat) (Level)

(4) Purpose of Well: domestic home
(Domestic Irrigation Municipal, Industrial, Other)

Information upon completion of well:

(1) Diameter 2 inches.

(2) Total Depth 163 feet.

(3) Water Level 2 feet below top of ground.

(4) Cased to top, Size 2"


(5) Screen: Size 2", Length 5'

(6) Were any formations sealed against pollution?
 yes, no.

If YES depth of formation surface

Why _____

Drillers Remarks: _____

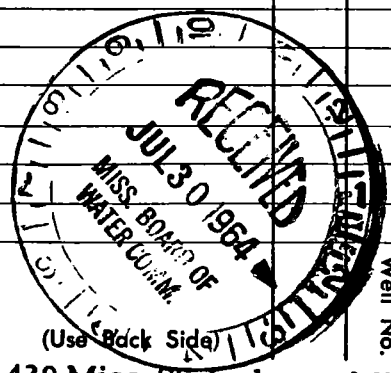

Well No. _____

1940

1941

1942

1970