

MISSISSIPPI BOARD OF WATER COMMISSIONERS

HANCOCK

K 2073 WATER WELL DRILLERS LOG

7-21-64

K

Date: 7-21, 1964, Driller: Sutter Well Works County (Hancock)

(Name)

(1) Owner of Land: Chaplain O.H. Buckley  
(Name)

Box 483 - Sanatorium, Texas  
(Address)

(2) Location: NE 1/4, SW 1/4, Sec. 10 T8S R44W

5 miles W of Bay St. Louis  
(distance) (direction) (Nearest Town)

(3) Topography: flat  
(High) (Flat) (Level)

(4) Purpose of Well: domestic home  
(Domestic Irrigation  
Municipal, Industrial, Other)

Description & Color of Materials Sand, Clay, Red Clay, Shell, etc.	Thick- ness Feet	Depth Feet
---	------------------------	---------------

clay	15	15
------	----	----

sand	24	39
------	----	----

clay	127	166
------	-----	-----

sand	14	180
------	----	-----

Information upon completion of well:

(1) Diameter 2 inches.

(2) Total Depth 180 feet.

(3) Water Level 1/2 feet <sup>above</sup> Flow below top of ground.

(4) Cased to 175, Size 2"

(5) Screen: Size 2", Length 5'


(6) Were any formations sealed against pollution?

       yes,        no.

If YES depth of formation       

Why       

Drillers Remarks:       

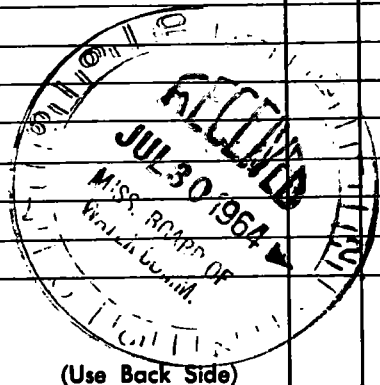

(Use Back Side)

Well No.

