

K-2078
8-21-64

WATER WELL DRILLERS LOG

K

Date: 8-21, 1964, Driller: Sutter Well Works County Hancock
(Name)

	Description & Color of Materials Sand, Clay, Red Clay, Shell, etc.	Thick- ness Feet	Depth Feet
(1) Owner of Land: <u>August Fouasson</u> (Name) <u>Cleveland, Miss.</u> (Address)	Clay - sand streaks	55	55
	Clay	13	68
	Sand	112	180
(2) Location: <u>NW 1/4, SE 1/4, Sec. 35 T. 86 N. R. 14 W</u> <u>1</u> miles <u>W</u> of <u>Bay St Louis</u> (distance) (direction) (Nearest Town)	Clay	30	210
	Sand	48	258
	Clay	67	325
(3) Topography: <u>flat</u> (Hilly) (Flat) (Level)	Sand	26	351
	Clay	74	425
(4) Purpose of Well: <u>domestic Home</u> (Domestic Irrigation Municipal, Industrial, Other)	Sand	37	462


Information upon completion of well:

- (1) Diameter 2 inches.
- (2) Total Depth 462 feet.
- (3) Water Level 7 feet below top of ground. 447
- (4) Cased to agl, Size 2"
- (5) Screen: Size 2", Length 15'
- (6) Were any formations sealed against pollution?
 yes, no.

If YES depth of formation surface

Why _____

Drillers Remarks: _____

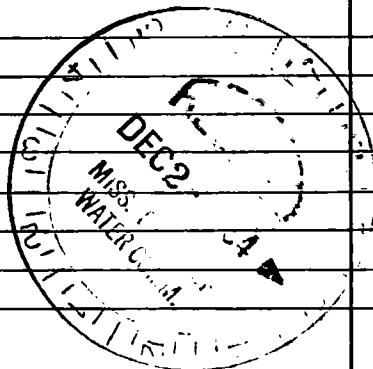

(Use Back Side)

Well No.

Handwritten header text, possibly a title or date.

Vertical list of numbers on the left side of the page.

Vertical list of numbers and some illegible text in the middle-left section.

Main body of handwritten text, including a large number '1000' and other illegible characters.

Vertical text on the right side of the page, possibly a signature or date.

Horizontal line of text at the bottom of the page.