

HANCOCK
K 7081

MISSISSIPPI BOARD OF WATER COMMISSIONERS

11-18-64

WATER WELL DRILLERS LOG

Date: 11-18, 1964, Driller: Sutter Well Works County Hancock
(Name)

(1) Owner of Land: D.T. Mangt, Jr.
(Name)
Box 52046 - New Orleans, La.
(Address)

(2) Location: S E 1/4, N W 1/4, Sec. 32 T8S R 14, W
5 miles W of Baytown
(distance) (direction) (Nearest Town)

(3) Topography: flat
(Hilly) (Flat) (Level)

(4) Purpose of Well: domestic Home
(Domestic Irrigation
Municipal, Industrial, Other)

Description & Color of Materials Sand, Clay, Red Clay, Shell, etc.	Thick- ness Feet	Depth Feet
<u>Clay</u>	<u>5</u>	<u>5</u>
<u>sand</u>	<u>49</u>	<u>54</u>
<u>Clay</u>	<u>44</u>	<u>98</u>
<u>sand</u>	<u>23</u>	<u>121</u>
<u>Clay</u>	<u>15</u>	<u>136</u>
<u>sand</u>	<u>14</u>	<u>150</u>

Information upon completion of well:

(1) Diameter 2 inches.

(2) Total Depth 150 feet.

(3) Water Level 1 feet above Flow below top of ground.

(4) Cased to all, Size 2"


(5) Screen: Size 2", Length 5'

(6) Were any formations sealed against pollution?
 yes, no.

If YES depth of formation Surface

Why _____

Drillers Remarks: _____

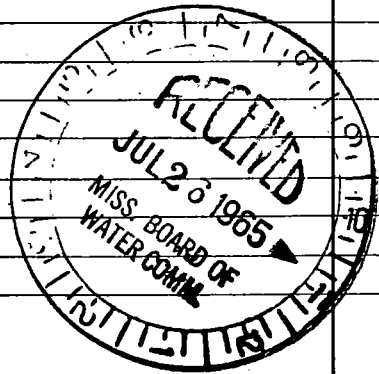

(Use Back Side)

Well No. _____

The first part of the document is a list of names and dates, possibly representing a schedule or a record of events. The text is heavily obscured by noise and artifacts, making it difficult to read. Some legible fragments include:

... 1911 ...
 ... 1912 ...
 ... 1913 ...
 ... 1914 ...
 ... 1915 ...
 ... 1916 ...
 ... 1917 ...
 ... 1918 ...
 ... 1919 ...
 ... 1920 ...

The second part of the document contains a table with several columns and rows. The data is mostly illegible due to the same noise and artifacts seen in the first part. Some faint numbers and symbols are visible:

1	2	3	4
...
...
...

The third part of the document appears to be a continuation of the table or a separate set of data. It contains several lines of text and numbers, which are also largely illegible. Some faint fragments are visible:

... 1921 ...
 ... 1922 ...
 ... 1923 ...
 ... 1924 ...
 ... 1925 ...