

HANCOCK  
K. 2088  
3-12-65

MISSISSIPPI BOARD OF WATER COMMISSIONERS

WATER WELL DRILLERS LOG

A

Date: 3-12, 1965, Driller: Lutter Well Works County Hancock  
(Name)

(1) Owner of Land: Roland Lailan  
(Name)  
Bay St. Louis  
(Address)

(2) Location: NE 1/4, SW 1/4, Sec. 35 T85R14W  
1 miles W of Bay St. Louis  
(distance) (direction) (Nearest Town)

(3) Topography: flat  
(Hilly) (Flat) (Level)

(4) Purpose of Well: domestic home  
(Domestic Irrigation  
Municipal, Industrial, Other)

Description & Color of Materials Sand, Clay, Red Clay, Shell, etc.	Thick- ness Feet	Depth Feet
Clay	5	5
Sand	65	70
Clay	16	86
Sand	52	138
Clay - Sand str.	138	276
Clay	58	334
Sticky clay	70	404
Fine sand	11	415
Sand	49	464

Information upon completion of well:

(1) Diameter 2 inches.

(2) Total Depth 464 feet.

(3) Water Level 2 feet below top of ground.  
452

(4) Cased to GL, Size 2"

(5) Screen: Size 2", Length 10'

(6) Were any formations sealed against pollution?  
yes,  no.


If YES depth of formation \_\_\_\_\_

Why \_\_\_\_\_

Drillers Remarks: \_\_\_\_\_

\_\_\_\_\_

\_\_\_\_\_

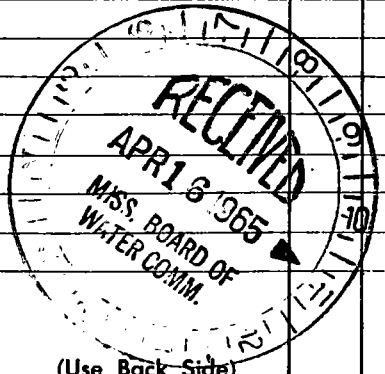

Well No. \_\_\_\_\_

