

K 2089

3-15-65

WATER WELL DRILLERS LOG

A

Date: 3-15, 1965, Driller: Sutton Well Works County Hancock
 (Name)

(1) Owner of Land: 2-2. Rebel, Jr.
 (Name)
Bay St. Louis
 (Address)

(2) Location: SW 1/4, NE 1/4, Sec. 37 T85R 14W
2 miles W of Bay
 (distance) (direction) (Nearest Town)

(3) Topography: flat
 (Hilly) (Flat) (Level)

(4) Purpose of Well: domestic home
 (Domestic Irrigation
 Municipal, Industrial, Other)

Description & Color of Materials Sand, Clay, Red Clay, Shell, etc.	Thick- ness Feet	Depth Feet
Clay	114	114
sand	24	138
Clay - sand streak	74	212
sand	11	223
Clay	26	249
sand	37	286
Clay - sand str.	114	400
sand	36	436
Clay	13	449

Information upon completion of well:

(1) Diameter 2 inches.

(2) Total Depth 449 feet.

(3) Water Level 3 feet below top of ground. above Flood

(4) Cased to ape, Size 2"


(5) Screen: Size 2", Length 10'

(6) Were any formations sealed against pollution?
 _____ yes, no.

If YES depth of formation _____

Why _____

Drillers Remarks: 13' blank pipe below screen.

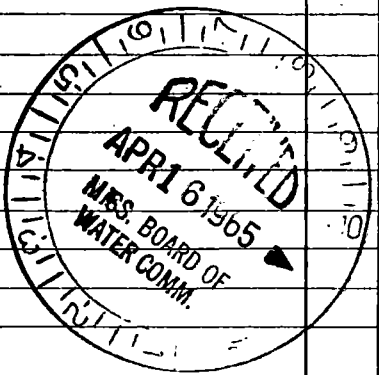

(Use Back Side)

Well No.

