

HANCOCK MISSISSIPPI BOARD OF WATER COMMISSIONERS

K 2091

3-30-65

WATER WELL DRILLERS LOG

A

Date: 3-30, 1965, Driller: Sutter Well Works County Hancock  
(Name)

- (1) Owner of Land: Miss. Contractors  
(Name)  
Pearlington Miss.  
(Address)
- (2) Location: NE 1/4, NE 1/4, Sec. 40 T8SR 14 W  
5 miles W, of Bay  
(distance) (direction) (Nearest Town)
- (3) Topography: flat  
(Hilly) (Flat) (Level)
- (4) Purpose of Well: domestic - office  
(Domestic Irrigation) (Municipal, Industrial, Other)

Description & Color of Materials Sand, Clay, Red Clay, Shell, etc.	Thick- ness Feet	Depth Feet
Clay	15	15
sand	26	41
Clay - sand str.	84	125
sand	17	142
clay	23	165
sand	20	185


Information upon completion of well:

- (1) Diameter 2 inches.
- (2) Total Depth 185 feet.
- (3) Water Level 1 feet below top of ground.  
180
- (4) Cased to all, Size 2"
- (5) Screen: Size 2", Length 5'
- (6) Were any formations sealed against pollution?  
 yes,  no.

If YES depth of formation Surface

Why \_\_\_\_\_

Drillers Remarks: \_\_\_\_\_

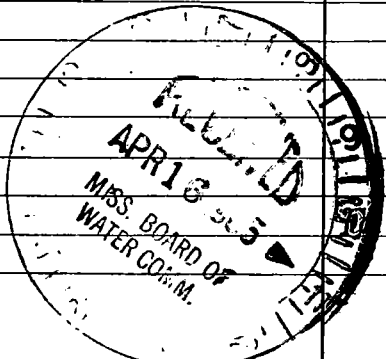

Well No. \_\_\_\_\_

(Use Back Side)

Handwritten notes, possibly bleed-through from the reverse side of the page. The text is extremely faint and illegible due to the high contrast and noise of the scan. Some faint words like "The" and "and" are visible.