

HANCOCK

MISSISSIPPI BOARD OF WATER COMMISSIONERS

K 2092

4-9-65

WATER WELL DRILLERS LOG

Date: 4-9, 1965, Driller: Sutter Well Works County Hancock

(Name)

(1) Owner of Land: Fred Schalp (Name)

Bay St. Louis, Miss. (Address)

(2) Location: SW 1/4, NE 1/4, Sec. 47 T85R14W

5 miles W of Bay St Louis (distance) (direction) (Nearest Town)

(3) Topography: flat (Hilly) (Flat) (Level)

(4) Purpose of Well: Domestic Home (Domestic Irrigation Municipal, Industrial, Other)

Description & Color of Materials Sand, Clay, Red Clay, Shell, etc.	Thick-ness Feet	Depth Feet
Clay	10	10
Clay - sand streaks	132	142
sand	33	175

Information upon completion of well:

(1) Diameter 2 inches.

(2) Total Depth 175 feet.

(3) Water Level 2 feet below top of ground. 170

(4) Cased to 170, Size 2"

(5) Screen: Size 2", Length 5'


(6) Were any formations sealed against pollution?

yes, no.

If YES depth of formation Surface

Why

Drillers Remarks:

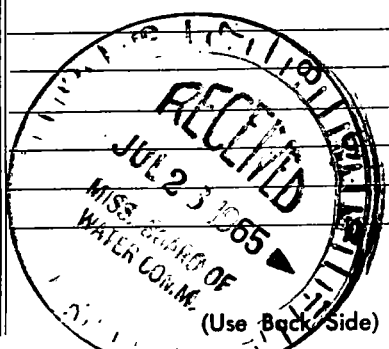

Well No.

Journal of the [illegible] [illegible] [illegible]

[illegible handwritten notes]

1877

5

1878

5

[illegible handwritten note]