

HANCOCK  
K 2096  
5-7-65

MISSISSIPPI BOARD OF WATER COMMISSIONERS

WATER WELL DRILLERS LOG

Date: 5-7, 1965, Driller: Jutter Well Works County Hancock  
(Name)

(1) Owner of Land: John Becker  
(Name)  
1731 Manning St. - N.O. La.  
(Address)

(2) Location: NW 1/4, NW 1/4, Sec. 29 T85R74  
5 miles W of Bay St Louis  
(distance) (direction) (Nearest Town)

(3) Topography: flat  
(Hilly) (Flat) (Level)

(4) Purpose of Well: domestic Home  
(Domestic Irrigation  
Municipal, Industrial, Other)

Description & Color of Materials Sand, Clay, Red Clay, Shell, etc.	Thick- ness Feet	Depth Feet
<u>Clay-sand streaks</u>	<u>42</u>	<u>42</u>
<u>sand</u>	<u>12</u>	<u>54</u>
<u>Clay</u>	<u>31</u>	<u>85</u>
<u>sand + gravel</u>	<u>27</u>	<u>118</u>

Information upon completion of well:

(1) Diameter 2 inches.

(2) Total Depth 118 feet.

(3) Water Level 1/2 <sup>above</sup> 113 feet below top of ground.

(4) Cased to top, Size 2"


(5) Screen: Size 2", Length 5'

(6) Were any formations sealed against pollution?  
no.

If YES depth of formation \_\_\_\_\_

Why \_\_\_\_\_

Drillers Remarks: \_\_\_\_\_

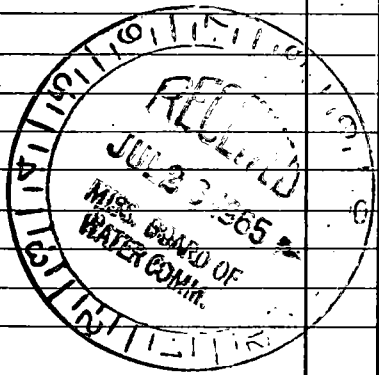

Well No.

(Use Back Side)

Handwritten text at the top of the page, possibly a title or header.

Main body of handwritten text, appearing to be a list or series of entries.

Continuation of handwritten text, possibly including numerical data or dates.

Bottom section of handwritten text, possibly a conclusion or summary.