

HANCOCK

MISSISSIPPI BOARD OF WATER COMMISSIONERS

K 7098

5-24-65

WATER WELL DRILLERS LOG

Date: 5-24, 19 65, Driller: Sutter Well Works County Hancock

(Name)

(1) Owner of Land: Adam Held (Name)

5541 Lafaye St. N.O., La (Address)

(2) Location: SW 1/4, SW 1/4, Sec. 37 T. 25R. 14, W 3 miles W of Bay St Louis (distance) (direction) (Nearest Town)

(3) Topography: flat (Hilly) (Flat) (Level)

(4) Purpose of Well: Domestic Home (Domestic Irrigation Municipal, Industrial, Other)

Description & Color of Materials Sand, Clay, Red Clay, Shell, etc.	Thick- ness Feet	Depth Feet
clay	7	7
sand	27	34
clay	11	45
sand + gravel	85	130
clay w/ sand shales	135	265
sand	60	325

Information upon completion of well:

(1) Diameter 2 inches.

(2) Total Depth 325 feet.

(3) Water Level 315 feet below top of ground.

(4) Cased to top, Size 2"


(5) Screen: Size 2", Length 10'

(6) Were any formations sealed against pollution? yes, no.

If YES depth of formation

Why

Drillers Remarks:

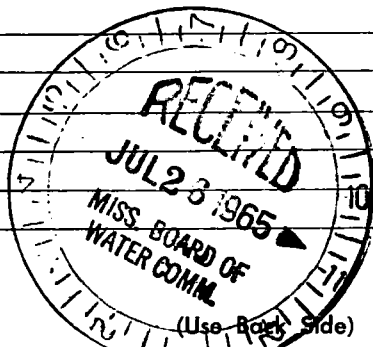

Well No.

Account of the ...

...

...

