

K 2099
6-15-65

WATER WELL DRILLERS LOG

Date: 6-15, 1965, Driller: Lutter Well Works County Hancock
(Name)

(1) Owner of Land: Ed Larrout
(Name)
Bay St. Louis Miss.
(Address) town

(2) Location: 1/4, 1/4, Sec. T85R14N
10 miles W, Bay St Louis
(distance) (direction) (Nearest Town)

(3) Topography: flat
(Hilly) (Flat) (Level)

(4) Purpose of Well: domestic home
(Domestic Irrigation
Municipal, Industrial, Other)

Description & Color of Materials Sand, Clay, Red Clay, Shell, etc.	Thick- ness Feet	Depth Feet
<u>Clay - sand streaks</u>	<u>55</u>	<u>55</u>
<u>sand + gravel</u>	<u>13</u>	<u>68</u>
<u>Clay - sand streaks</u>	<u>242</u>	<u>310</u>
<u>sand</u>	<u>31</u>	<u>341</u>

Information upon completion of well:

(1) Diameter 2 inches.

(2) Total Depth 341 feet.


(3) Water Level 4 feet above ^{Flow} below top of ground.

(4) Cased to 331 all, Size 2"

(5) Screen: Size 2", Length 10'

(6) Were any formations sealed against pollution?
no

If YES depth of formation _____
Why _____
Drillers Remarks: _____

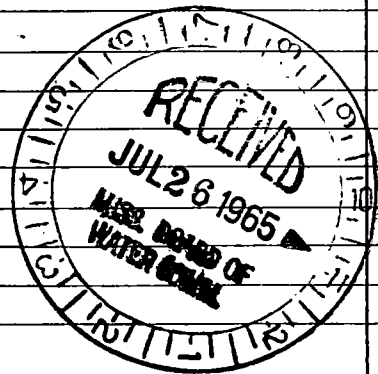

(Use Back Side)

Well No.

