

HANCOCK
K 2102
6-24-65

WATER WELL DRILLERS LOG

Date: 6-24, 1965, Driller: Butter Well Works County 7 Hancock
(Name)

	Description & Color of Materials Sand, Clay, Red Clay, Shell, etc.	Thick- ness Feet	Depth Feet
(1) Owner of Land: <u>James Jones</u> (Name) <u>% 2217 Nancy Ave. Merand Pa.</u> (Address)	Clay	15	15
(2) Location: <u>NE 1/4, SW 1/4, Sec. 40 T8SR14, W</u> <u>5</u> miles <u>W</u> of <u>Beyst Louis</u> (distance) (direction) (Nearest Town)	sand	21	36
	Clay	90	126
	sand	8	134
	Clay	21	155
	sand	16	171
(3) Topography: <u>flat</u> (Hilly) (Flat) (Level)			
(4) Purpose of Well: <u>domestic home</u> (Domestic Irrigation Municipal, Industrial, Other)			


Information upon completion of well:

- (1) Diameter 2 inches.
- (2) Total Depth 171 feet.
- (3) Water Level 4 feet below top of ground.
- (4) Cased to gle, Size 2"
- (5) Screen: Size 2", Length 5'
- (6) Were any formations sealed against pollution?
 yes, no.

If YES depth of formation Surface

Why _____

Drillers Remarks: _____

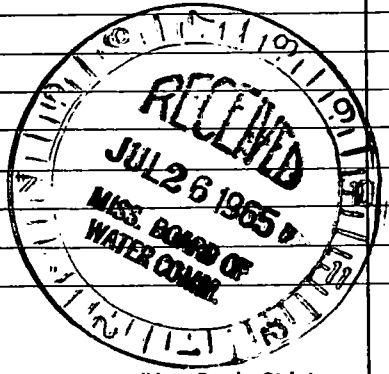

(Use Back Side)

Well No.

Handwritten header text, possibly a title or date, including the word "January".

11 31
22 12
32 21
43 30
54 39
65 48
76 57
87 66
98 75

Handwritten notes or calculations, possibly related to the numbers on the left.

Handwritten notes or calculations, possibly related to the numbers on the left.

Handwritten notes or calculations, possibly related to the numbers on the left.

101
102

Handwritten text at the bottom of the page.