

HANCOCK

MISSISSIPPI BOARD OF WATER COMMISSIONERS

K 2103

6-25-65

WATER WELL DRILLERS LOG

Date: 6-25, 1965, Driller: Lutter Well Works County Hancock

(Name)

(1) Owner of Land: John Escude (Name)

To TAC Amusement Co., N.O.L.A. (Address)

(2) Location: NW 1/4, SE 1/4, Sec. 46 T. 85R. 9S.

3 miles W of Bay St Louis (distance) (direction) (Nearest Town)

(3) Topography: flat (Hilly) (Flat) (Level)

(4) Purpose of Well: domestic home (Domestic Irrigation Municipal, Industrial, Other)

Description & Color of Materials Sand, Clay, Red Clay, Shell, etc.

Thick-ness Feet

Depth Feet

Clay

10

10

Sand

60

70

Clay

76

146

Sand

15

161

Information upon completion of well:

(1) Diameter 2 inches.

(2) Total Depth 161 feet.

(3) Water Level 1 feet below top of ground.

(4) Cased to 156 feet, Size 2"

(5) Screen: Size 2", Length 5'


(6) Were any formations sealed against pollution?

yes, no.

If YES depth of formation Surface

Why

Drillers Remarks:

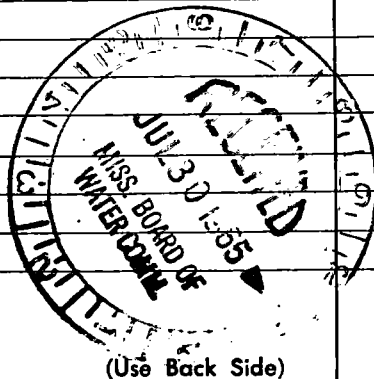

Well No.

Handwritten header text, possibly a title or date, located at the top of the page.

10
10
Main body of handwritten text, including several lines of illegible script and some faint markings.

