

K 2107
7-1-65

WATER WELL DRILLERS LOG

Date: 7-1, 1965, Driller: Sutton Well Wks. County Hancock
(Name)

(1) Owner of Land: F.N. Burmaster
(Name)
10,030 David Drive, Baton Rouge, La.
(Address)

(2) Location: NE 1/4, SW 1/4, Sec. 42 T. 85R. 14, W
2 miles W of Bay St Louis
(distance) (direction) (Nearest Town)

(3) Topography: flat
(Hilly) (flat) (Level)

(4) Purpose of Well: domestic home
(Domestic Irrigation
Municipal, Industrial, Other)

Description & Color of Materials Sand, Clay, Red Clay, Shell, etc.	Thick- ness Feet	Depth Feet
<u>Clay</u>	<u>15</u>	<u>15</u>
<u>sand</u>	<u>17</u>	<u>32</u>
<u>Clay</u>	<u>90</u>	<u>122</u>
<u>sand</u>	<u>12</u>	<u>134</u>

Information upon completion of well:

(1) Diameter 2 inches.

(2) Total Depth 134 feet.

(3) Water Level 8 feet below top of ground. 129

(4) Cased to ank, Size 2"


(5) Screen: Size 2", Length 5'

(6) Were any formations sealed against pollution?
 yes, no.

If YES depth of formation surface

Why _____

Drillers Remarks: _____

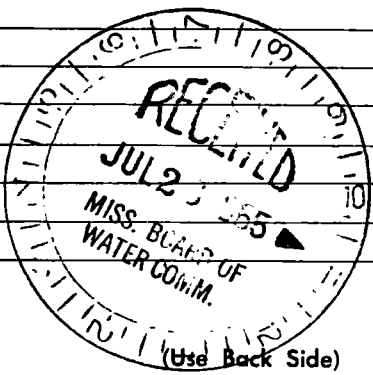

Well No.

Handwritten text at the top left, possibly a name or title.

Handwritten text at the top center, possibly a date or location.

Handwritten text at the top right, possibly a page number or reference.

Vertical handwritten text on the left side, possibly a list or notes.

Handwritten text in the middle left section.

Handwritten text in the middle right section.

Handwritten text in the lower middle section.

Handwritten text in the lower middle section, possibly a signature or name.

Handwritten text in the lower right section.

Handwritten text in the lower right section.

