

HANCOCK

MISSISSIPPI BOARD OF WATER COMMISSIONERS

K. 2110

8-17-65

WATER WELL DRILLERS LOG

Date: 8-17, 1965, Driller: Lutter Well Works County Hancock

(Name)

(1) Owner of Land: Eugene Clem  
 (Name)  
 New Orleans La.  
 (Address)

(2) Location: NW 1/4, NW 1/4, Sec. 19 T8S R14 W  
 5 miles W of Bay St Louis  
 (distance) (direction) (Nearest Town)

(3) Topography: flat  
 (Hilly) (Flat) (Level)

(4) Purpose of Well: Domestic Home  
 (Domestic Irrigation  
 Municipal, Industrial, Other)

Description & Color of Materials Sand, Clay, Red Clay, Shell, etc.	Thick- ness Feet	Depth Feet
Clay	10	10
sand	29	39
Clay	62	101
sand	34	135
Clay	9	144
sand	34	178

Information upon completion of well:

(1) Diameter 2 inches.

(2) Total Depth 178 feet.

(3) Water Level surface flow feet below top of ground.

(4) Cased to 173, Size 2"

(5) Screen: Size 2", Length 5'


(6) Were there any formations sealed against pollution?

yes, no.

If YES depth of formation

Why

Drillers Remarks:

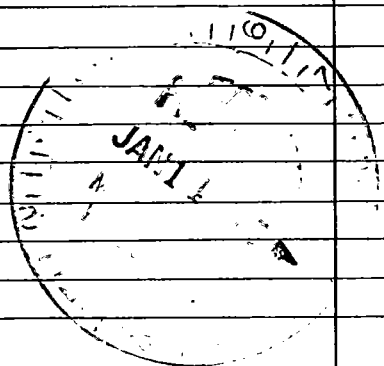

(Use Back Side)

Well No.

Handwritten title or header text, possibly "Handwritten Title" or similar, written in a cursive style.

Vertical handwritten notes on the left side of the page, including numbers and possibly names or dates.

Vertical handwritten notes in the middle-left section, appearing as a list or series of entries.

Main body of handwritten text in the upper right quadrant, consisting of several lines of cursive script.

Handwritten text in the lower right quadrant, possibly a signature or a specific note.

Large area of handwritten text at the bottom of the page, which is very faint and difficult to read.