

HANCOCK

WATER WELL DRILLERS LOG

Date: 8-19-65, 1965, Driller: Sutton Well Works County Hancock (Name)

(1) Owner of Land: Howard Cooley  
 (Name)  
RT 1 Box 455 MB - Bay St Louis  
 (Address) Miss.

(2) Location: NE 1/4, NE 1/4, Sec. 47 T8S R14  
5 miles W of Bay St Louis  
 (distance) (direction) (Nearest Town)

(3) Topography: flat  
 (Hilly) (Flat) (Level)

(4) Purpose of Well: domestic Home  
 (Domestic Irrigation  
 Municipal, Industrial, Other)

Description & Color of Materials Sand, Clay, Red Clay, Shell, etc.	Thick- ness Feet	Depth Feet
<u>Clay</u>	<u>12</u>	<u>12</u>
<u>Sand</u>	<u>26</u>	<u>38</u>
<u>Clay</u>	<u>111</u>	<u>149</u>
<u>Sand - gravel</u>	<u>24</u>	<u>173</u>


Information upon completion of well:

- (1) Diameter 2 inches.
- (2) Total Depth 173 feet.
- (3) Water Level 4 feet below top of ground. 168
- (4) Cased to cell, Size 2"
- (5) Screen: Size 2", Length 5'
- (6) Were any formations sealed against pollution?  
 yes,  no.

If YES depth of formation \_\_\_\_\_

Why \_\_\_\_\_

Drillers Remarks: \_\_\_\_\_

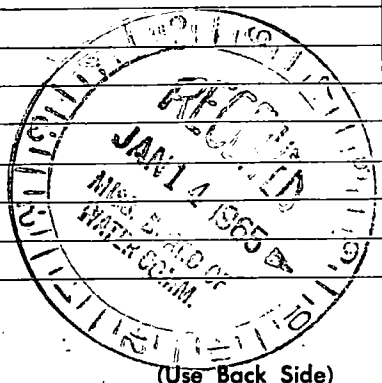

Well No. \_\_\_\_\_

Handwritten mark at the top of the page.



Faint, illegible text at the top of the page, possibly a header or title.

10  
11  
12  
13  
14  
15

Main body of faint, illegible text, possibly a list or a series of entries.

16

17

18

19

20

21

22

23

24

25

26

27

28