

K 2113

9-65

WATER WELL DRILLERS LOG

Date: Sept., 1965, Driller: Joe Miller County Hancock  
 (Name)

(1) Owner of Land: \_\_\_\_\_  
 (Name)  
Bay St Louis, Miss  
 (Address)

(2) Location: \_\_\_\_\_ 1/4, \_\_\_\_\_ 1/4, Sec. T8S R14E  
 \_\_\_\_\_ miles \_\_\_\_\_ of Bay St Louis  
 (distance) (direction) (Nearest Town)

(3) Topography: Flat  
 (Hilly) (Flat) (Level)

(4) Purpose of Well: Domestic Home  
 (Domestic Irrigation  
 Municipal, Industrial, Other)

Description & Color of Materials Sand, Clay, Red Clay, Shell, etc.	Thick- ness Foot	Depth Feet
Clay	5	5
White Sand	15	20
Black Sand	35	55
Clay & Sand Mix	45	100
White Sand	20	120
Sand & Clay Sm Br.	38	158
Hard Blue Clay	64	222
Hard Blue Clay	19	241
Sand (gray) Fair	12	253
Sand " Good	11	264
Hard Blue Clay	4	268

Information upon completion of well:

(1) Diameter 2' inches.

(2) Total Depth 268 feet.

(3) Water Level 14' feet below top of ground.

(4) Cased to 253, Size 2"

(5) Screen: Size 2", Length 10'


(6) Were any formations sealed against pollution?  
 \_\_\_\_\_ yes, \_\_\_\_\_ no.

If YES depth of formation \_\_\_\_\_

Why \_\_\_\_\_

Drillers Remarks: \_\_\_\_\_

5' Fuel Pipe  
Used.

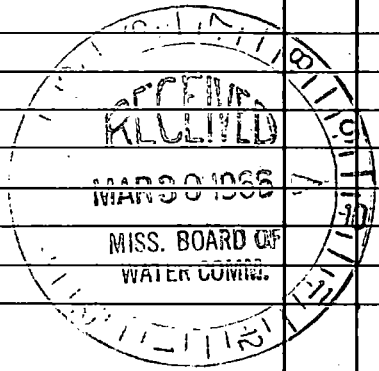

(Use Back Side)

Well No.

N

1000

Wilm Rd

90 HKY

W

E

OLD HKY



51