

HANCOCK

MISSISSIPPI BOARD OF WATER COMMISSIONERS

K 2115

9-24-65

WATER WELL DRILLERS LOG

Date: 9-24, 1965, Driller: Water Well Works County Hancock

(Name)

(1) Owner of Land: Henry Johnston

(Name)

Bay St. Louis, Miss.

(Address)

(2) Location: NW 1/4, SE 1/4, Sec. 40 SR 14 W

5 miles W of Bay St. Louis

(distance)

(direction)

(Nearest Town)

(3) Topography: flat

(Hilly)

(Flat)

(Level)

(4) Purpose of Well: domestic home

(Domestic Irrigation  
Municipal, Industrial, Other)

Description & Color of Materials  
Sand, Clay, Red Clay, Shell, etc.

Thick-  
ness  
Feet

Depth  
Feet

Sand

43

43

Clay

45

88

clay - sand streaks

23

110

Sand

34

144

Clay

115

259

Sand

42

301

Information upon completion of well:

(1) Diameter 2 inches.

(2) Total Depth 301 feet.

(3) Water Level 1/2 feet below top of ground. How above

291

(4) Cased to top, Size 2"

(5) Screen: Size 2", Length 10'


(6) Were any formations sealed against pollution?

yes,  no.

If YES depth of formation surface

Why \_\_\_\_\_

Drillers Remarks: \_\_\_\_\_

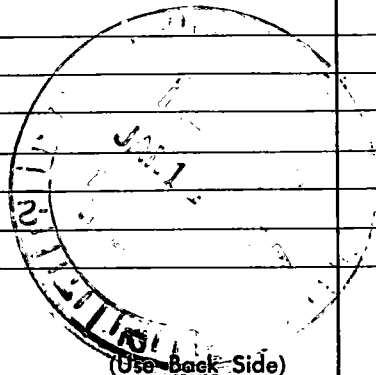

(Use Back Side)

Well No.

Handwritten header text, possibly a title or date, located at the top of the page.

Vertical list of numbers on the left side of the page, including 100, 101, 102, 103, 104, 105, 106, 107, 108, 109, 110.

Vertical list of numbers on the left side of the page, including 111, 112, 113, 114, 115, 116, 117, 118, 119, 120.

Main body of handwritten text, appearing as a list or series of entries, possibly containing names and associated numbers.

Handwritten text block in the lower middle section of the page, possibly a summary or a specific entry.

Handwritten text block at the bottom of the page, possibly a signature or a final note.