

MISSISSIPPI BOARD OF WATER COMMISSIONERS

HANCOCK

K 2116
10-6-65

WATER WELL DRILLERS LOG

Date: 10-6, 1965, Driller: Sutter Well Wks. County Hancock
(Name)

(1) Owner of Land Mary Monasco
(Name)
Box 22, Bay St. Louis, Miss.
(Address)

(2) Location: NE 1/4, NE 1/4, Sec 39 T85R14W
5 miles W of Bay St. Louis
(distance) (direction) (Nearest Town)

(3) Topography: flat
(Hilly) (Flat) (Level)

(4) Purpose of Well: domestic Home
(Domestic Irrigation
Municipal, Industrial, Other)

Description & Color of Materials Sand, Clay, Red Clay, Shell, etc.	Thick- ness Feet	Depth Feet
Clay	22	22
Sand	33	55
Clay - sand streaks	122	177
fine sand	17	194
Clay & sand st.	61	255
sand	33	288
Clay	56	344
fine sand	21	365
sand	11	376
Clay	38	414
fine sand	22	436
Clay	57	493
sand	23	516

Information upon completion of well:

(1) Diameter 2 inches.

(2) Total Depth 516 feet. ^{Flow} ~~here~~

(3) Water Level 15 ~~30~~ feet ^{above} below top of ground. 586

(4) Cased to all, Size 2"


(5) Screen: Size 2", Length 10'

(6) Were any formations sealed against pollution?
 yes, no.

If YES depth of formation _____

Why _____

Drillers Remarks: _____

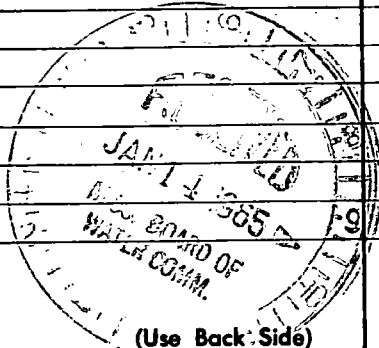

Well No.

