

K 2117

10-18-65

WATER WELL DRILLERS LOG

Date: 10-18, 1965, Driller: Sutton Well Works County Hancock

(Name)

(1) Owner of Land: David Bonner  
 (Name)  
New Orleans La  
 (Address) 2B

(2) Location: Sec 1/4, NE 1/4, Sec. 16 T. 15R. 14W  
3 miles W of Bay St. Louis  
 (distance) (direction) (Nearest Town)

(3) Topography: Flat  
 (Hilly) (Flat) (Level)

(4) Purpose of Well: domestic Home  
 (Domestic Irrigation  
 Municipal, Industrial, Other)

Description & Color of Materials Sand, Clay, Red Clay, Shell, etc.	Thick- ness Feet	Depth Feet
Clay	30	30
sand	38	68
Clay	56	124
Clay - sand streaks	84	208
sand	30	238
Clay	19	257
sand	14	271
Clay - sand streaks	101	372
sand	16	388

Information upon completion of well:

(1) Diameter 2 inches.

(2) Total Depth 388 feet.

(3) Water Level 2 feet <sup>above</sup> below top of ground. 378

(4) Cased to alt, Size 2"


(5) Screen: Size 2", Length 10'

(6) Were any formations sealed against pollution?  
 \_\_\_\_\_ yes, \_\_\_\_\_ no.

If YES depth of formation \_\_\_\_\_

Why \_\_\_\_\_

Drillers Remarks: \_\_\_\_\_

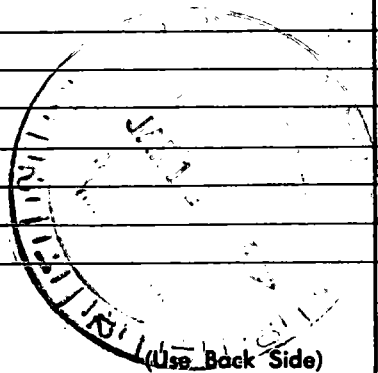

Well No.

Handwritten text at the top of the page, possibly a title or header, including the number "10" in the top left corner.

Main body of handwritten text, appearing to be a list or series of entries, possibly related to a survey or inventory.

Continuation of handwritten text, showing more entries or details from the list.

Final section of handwritten text at the bottom of the page, possibly a conclusion or summary.