

HANCOCK

MISSISSIPPI BOARD OF WATER COMMISSIONERS

K 2119

12-21-65

WATER WELL DRILLERS LOG

Date: 12-21, 1965, Driller: Sutter Well Works County Hancock

(Name)

(1) Owner of Land: James Lynn (Name) 809 Navy St. - Metairie, La. (Address)

(2) Location: SW 1/4, NE 1/4, Sec. 9 T. 85R14, W 5 miles NW of Bay St. Louis (distance) (direction) (Nearest Town)

(3) Topography: flat (Hilly) (Flat) (Level)

(4) Purpose of Well: Domestic Home (Domestic Irrigation Municipal, Industrial, Other)

Description & Color of Materials Sand, Clay, Red Clay, Shell, etc.

Thick-ness Feet

Depth Feet

Clay	13	13
sand	8	21
slay	9	30
sand	12	42
Clay	98	140
sand - gravel	18	158


Information upon completion of well:

- (1) Diameter 2 inches.
- (2) Total Depth 158 feet.
- (3) Water Level 5 feet below top of ground.
- (4) Cased to 153 ft, Size 2"
- (5) Screen: Size 2", Length 5'
- (6) Were any formations sealed against pollution?  yes,  no.

If YES depth of formation surface

Why

Drillers Remarks:

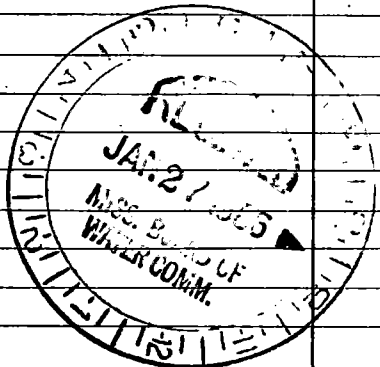

(Use Back Side)

Well No.

*[The page contains extremely faint and illegible text, likely bleed-through from the reverse side of the paper. No specific words or numbers can be reliably transcribed.]*