

K 2121

2-14-66

WATER WELL DRILLERS LOG

Date: 2-14, 1966, Driller: Sutter Well Works, Hancock County, Hancock

(Name)

(1) Owner of Land: <u>Sylvester Harrington</u> (Name)	Description & Color of Materials Sand, Clay, Red Clay, Shell, etc.	Thick- ness Feet	Depth Feet
<u>Waveland, Miss</u> (Address)	Clay	8	8
(2) Location: <u>SE 1/4, NW 1/4, Sec. 34 T8SR14, W</u>	Sand	54	62
<u>1</u> miles <u>N</u> of <u>Waveland</u> (distance) (direction) (Nearest Town)	Clay	86	148
(3) Topography: <u>flat</u> (Hilly) (Flat) (Level)	Sand	5	153
(4) Purpose of Well: <u>domestic home</u> (Domestic Irrigation Municipal, Industrial, Other)	Clay	15	168
	Sand	18	186


Information upon completion of well:

- (1) Diameter 2 inches.
- (2) Total Depth 186 feet.
- (3) Water Level 10 feet below top of ground.
- (4) Cased to 186 feet, Size 2".
- (5) Screen: Size 2", Length 5'.
- (6) Were any formations sealed against pollution?  
no.

If YES depth of formation \_\_\_\_\_

Why \_\_\_\_\_

Drillers Remarks: \_\_\_\_\_

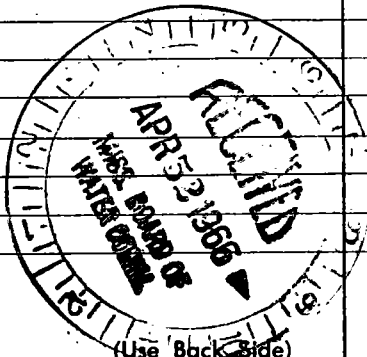

Well No.

1. ... ..

2  
3  
4  
5  
6  
7  
8

10  
11  
12  
13  
14  
15

Hydrogen

...

281

61

518

...