

K 2122

2-22-66

WATER WELL DRILLERS LOG

Date: 2-22, 1966, Driller: Sutter Well Works County Hancock

(Name)

(1) Owner of Land: B. C. McDonald, Jr.
 (Name)
Bay St. Louis Miss.
 (Address) TOWN

(2) Location: 1/4, 1/4, Sec. T8R19W
 miles 1W, Bay St. Louis
 (distance) (direction) (Nearest Town)

(3) Topography: flat
 (Hilly) (Flat) (Level)

(4) Purpose of Well: irrigation
 (Domestic Irrigation
 Municipal, Industrial, Other)

Description & Color of Materials Sand, Clay, Red Clay, Shell, etc.	Thick- ness Feet	Depth Feet
<u>Sand</u>	<u>71</u>	<u>71</u>
<u>Clay, sand streaks</u>	<u>54</u>	<u>125</u>
<u>Sand</u>	<u>42</u>	<u>167</u>
<u>Clay</u>	<u>41</u>	<u>208</u>
<u>Sand</u>	<u>34</u>	<u>242</u>

Information upon completion of well:

(1) Diameter 2 inches.

(2) Total Depth 242 feet.

(3) Water Level 19 feet below top of ground.
232

(4) Cased to all, Size 2"


(5) Screen: Size 2", Length 10'

(6) Were any formations sealed against pollution?
no

If YES depth of formation _____

Why _____

Drillers Remarks: _____

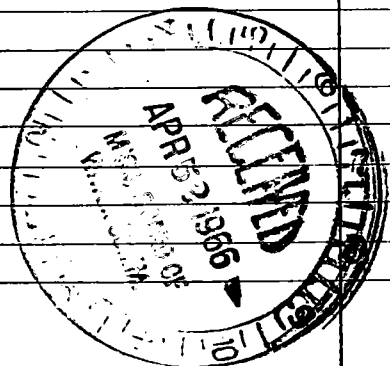

(Use Back Side)

Well No. _____

