

K 2123  
3-16-66

WATER WELL DRILLERS LOG

Date: 3-16, 1966, Driller: Little West Washo County Hancock  
(Name)

(1) Owner of Land: Eugene Munnier  
(Name)  
Hibernia Bank Bldg N.O.  
(Address)

(2) Location: NW 1/4, SW 1/4, Sec. 17 T25R14 W2  
5 miles NW of Bay St Louis  
(distance) (direction) (Nearest Town)

(3) Topography: flat  
(Hilly) (Flat) (Level)

(4) Purpose of Well: domestic  
(Domestic Irrigation  
Municipal, Industrial, Other)

Description & Color of Materials Sand, Clay, Red Clay, Shell, etc.	Thick- ness Feet	Depth Feet
Clay	10	10
Sand	52	62
Clay	7	69
Sand	11	80
Clay	68	148
Sand	19	167

Information upon completion of well:

(1) Diameter 2 inches.

(2) Total Depth 167 feet. Flow

(3) Water Level 1/2 feet Above below top of ground. 162

(4) Cased to top, Size 2"


(5) Screen: Size 2", Length 5'

(6) Were any formations sealed against pollution?  
no  yes,  no.

If YES depth of formation \_\_\_\_\_

Why \_\_\_\_\_

Drillers Remarks: \_\_\_\_\_

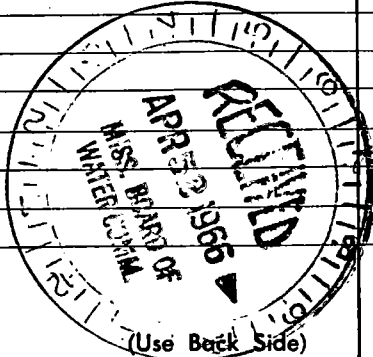

Well No. \_\_\_\_\_

The first part of the document discusses the importance of maintaining accurate records of all transactions. It emphasizes that every entry should be supported by a valid receipt or invoice. This ensures transparency and allows for easy verification of the data.

In the second section, the author details the various methods used to collect and analyze the data. This includes both manual and automated processes. The goal is to ensure that the information is both reliable and up-to-date.

The third part of the document focuses on the results of the analysis. It shows that there has been a significant increase in sales over the period covered. This is attributed to several factors, including improved marketing strategies and better customer service.

Finally, the document concludes with a series of recommendations for future actions. These include continuing to invest in marketing, maintaining high standards of customer service, and regularly reviewing financial performance.