

HANCOCK

K 2125

MISSISSIPPI BOARD OF WATER COMMISSIONERS

3-28-66

WATER WELL DRILLERS LOG

Date: 3-28, 1966, Driller: Sutton Well Works County Hancock
(When well drilled) (Name) (Where well is located)


(1) Owner of Land: Lawrence Leitz (Name)
241 Glenwood Dr. Metairie La. (Address)
(2) Location: SW 1/4, SW 1/4, Sec. 39 T8S R14 W
5 miles W, of Bay (distance) (direction) (Nearest Town)
(3) Topography: flat (Hilly) (Flat) (Level)
(4) Purpose of Well: Domestic Home (Domestic Irrigation Municipal, Industrial, Other)

Table with 3 columns: Description & Color of Materials (Sand, Clay, Red Clay, Shell, etc.), Thickness Feet, Depth Feet. Contains handwritten entries for clay and sand layers at various depths.

Information upon completion of well:

(1) Diameter 2 inches.
(2) Total Depth 170 feet.
(3) Water Level 6" ^{Flow} ^{above} feet below top of ground.
(4) Cased to all, Size 2"
(5) Screen: Size 2", Length 5'
(6) Were any formations sealed against pollution?
yes, no.

If YES depth of formation
Why
Drillers Remarks:
Yield in gpm: 30
Size pump: 1/3 Hp
Type power: elec

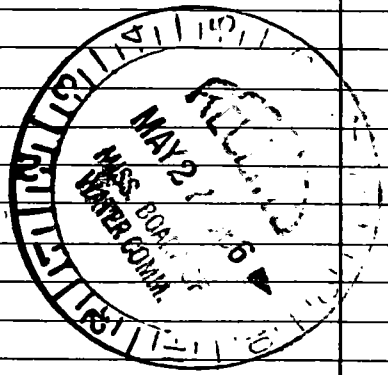

Faint, illegible text at the top of the page, possibly a header or title.

Handwritten notes in the upper section, including the number "8-2-2" and some illegible characters.

Handwritten notes in the middle section, including the number "170" and some illegible characters.

Handwritten notes in the lower section, including the number "22" and some illegible characters.

Faint, illegible text at the bottom of the page, possibly a footer or page number.