

HANCOCK

K 2129

MISSISSIPPI BOARD OF WATER COMMISSIONERS

4-6-66

WATER WELL DRILLERS LOG


Date: 4-6, 1966, Driller: Sutter Well Works Worcester County Hancock  
 (When well drilled) (Name) (Where well is located)

(1) Owner of Land: Hancock Homes  
 (Name)  
Bay St. Louis  
 (Address)  
 (2) Location: SE 1/4, SE 1/4, Sec. 34 T85R14, W  
1 miles N, of Waveland  
 (distance) (direction) (Nearest Town)  
 (3) Topography: flat  
 (Hilly) (Flat) (Level)  
 (4) Purpose of Well: Domestic Home  
 (Domestic Irrigation, Municipal, Industrial, Other)

Description & Color of Materials Sand, Clay, Red Clay, Shell, etc.	Thick- ness Feet	Depth Feet
<u>sand</u>	<u>51</u>	<u>51</u>
<u>clay</u>	<u>40</u>	<u>91</u>
<u>sand</u>	<u>38</u>	<u>129</u>
<u>clay</u>	<u>47</u>	<u>176</u>
<u>clay - sand streaks</u>	<u>251</u>	<u>427</u>
<u>sand</u>	<u>66</u>	<u>493</u>

Information upon completion of well:

(1) Diameter 2 inches.  
 (2) Total Depth 493 feet.  
 (3) Water Level 11 feet below top of ground.  
 (4) Cased to 483 ~~212~~, Size 2"  
 (5) Screen: Size 2", Length 10'  
 (6) Were any formations sealed against pollution?  
 \_\_\_\_\_ yes,  no.  
 If YES depth of formation \_\_\_\_\_  
 Why \_\_\_\_\_  
 Drillers Remarks: \_\_\_\_\_  
 Yield in gpm: 20  
 Size pump: 1 hp  
 Type power: elec.

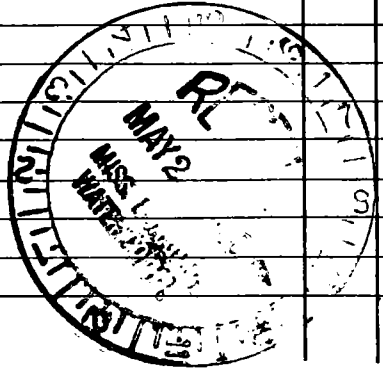

Account of the ...

... ..  
... ..  
1871