

Hancock

K 2136

6-20-66

MISSISSIPPI BOARD OF WATER COMMISSIONERS

WATER WELL DRILLERS LOG

Date: 6-20, 1966, Driller: Sutton Well Works County Hancock

(When well drilled)

(Name)

(Where well is located)

(1) Owner of Land: Lee Ferguson
835 Uranline St. N.O. La.
(2) Location: NE 1/4, SW 1/4, Sec. 29 T85R 14 W
4 miles NW of Waveland
(3) Topography: flat
(4) Purpose of Well: domestic Home

Table with 4 columns: Description & Color of Materials, Thickness Feet, Depth Feet. Rows contain handwritten entries: Clay 11 11, Sand 16 27, Clay 71 98, Sand 13 111.

Information upon completion of well:

(1) Diameter 2 inches.
(2) Total Depth 1115 feet.
(3) Water Level 2 feet below top of ground.
(4) Cased to 166, Size 2"
(5) Screen: Size 2", Length 5'
(6) Were any formations sealed against pollution?
yes, no.

If YES depth of formation surface


Why

Drillers Remarks:

Yield in gpm: 10

Size pump: unknown

Type power:

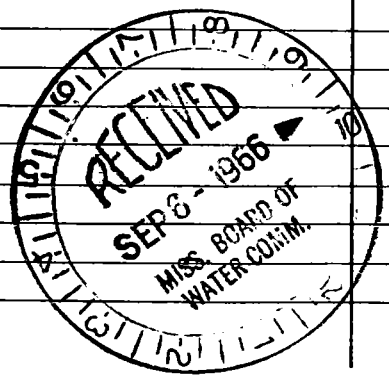

Handwritten notes, possibly bleed-through from the reverse side of the page. The text is extremely faint and illegible. Some faint words like "Total" and "Total" are visible.