

Hancock
R 2138

7-28-66 MISSISSIPPI BOARD OF WATER COMMISSIONERS

WATER WELL DRILLERS LOG

Date: 7-28, 1966, Driller: Sutter Well Works, Hancock
 (When well drilled) (Name) (Where well is located)

(1) Owner of Land: W. L. Easterling
 (Name)
Maefert, Miss.
 (Address)

(2) Location: NW 1/4, NE 1/4, Sec 36 T85R14W
1 miles West of Bay St Louis
 (distance) (direction) (Nearest Town)

(3) Topography: flat
 (Hilly) (Flat) (Level)

(4) Purpose of Well: Industrial
(Grocery)
 (Domestic Irrigation
 Municipal, Industrial, Other)

Information upon completion of well:

- (1) Diameter: 2 inches.
- (2) Total Depth: 472 feet.
- (3) Water Level: 15 feet below top of ground. 462
- (4) Cased to: cell, Size 2"
- (5) Screen: Size 2", Length 10'
- (6) Were any formations sealed against pollution?
 _____ yes, no.

If YES depth of formation _____

Why _____


Drillers Remarks: _____

Yield in gpm: 15

Size pump: 1/2

Type power: Elec

Description & Color of Materials Sand, Clay, Red Clay, Shell, etc.	Thick- ness Feet	Depth Feet
Clay	10	10
sand & gravel	195	205
Clay	202	407
sand	65	472

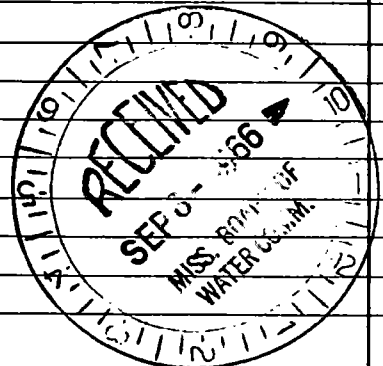

Mail this copy to Board of Water Commissioners 429 Miss. St. Jackson, Miss.

