

8-12-66

MISSISSIPPI BOARD OF WATER COMMISSIONERS

WATER WELL DRILLERS LOG

Date: 8-12, 1966, Driller: Gutter Well Works County Hancock
(When well drilled) (Name) (Where well is located)

(1) Owner of Land: Leon Lewis
(Name)

6016 Eldorado St. - N.D. La.

(2) Location: NE 1/4, SW 1/4, Sec. 40 T5R14W
5 miles W, of Bay St Louis
 (distance) (direction) (Nearest Town)

(3) Topography: Flat
(Hilly) (Flat) (Level)

(4) Purpose of Well: domestic Home
(Domestic Irrigation
Municipal, Industrial, Other)

Description & Color of Materials
Sand, Clay, Red. Clay, Shell, etc.

 Thick- ness Feet |

**Depth
Feet**

Paul

30

30

Clay

27

57

sand

21

78

Clair

101

179

Sand

15

194

Information upon completion of well:

(1) Diameter 2 inches.

(2) Total Depth 194 feet.

(3) Water Level 187 feet below top of ground.

(4) Cased to all, Size 22"

(5) Screen: Size 2", Length 5'

(6) Were any formations sealed against pollution?

✓ yes, _____ no.

If YES depth of formation Surface


Why _____

Drillers Remarks:_____

Yield in gpm: 10

Size pump: $\frac{1}{2}$

Type power: 50e

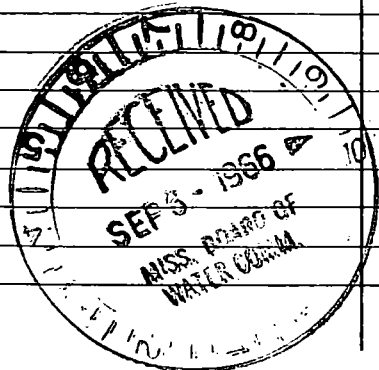

Mail this copy to Board of Water Commissioners 429 Miss. St. Jackson, Miss.

