

K 2142

9-66

WATER WELL DRILLERS LOG

Date: 9-5, 1966, Driller: Walter Penton County Hancock

(Name)


	Description & Color of Materials Sand, Clay, Red Clay, Shell, etc.	Thick- ness Feet	Depth Feet
(1) Owner of Land: <u>Mrs. C. Deconet</u>			
(Name)			
<u>Bay St. Louis Miss</u>	<u>Yellow Clay</u>	<u>16</u>	<u>0 to 16</u>
(Address)	<u>sand</u>	<u>8</u>	<u>24</u>
(2) Location: <u>SW 1/4, NE 1/4, Sec. 40 T8, R14, E1</u>	<u>Black Mud</u>	<u>36</u>	<u>60</u>
	<u>Blue clay</u>	<u>72</u>	<u>132</u>
<u>4</u> miles <u>West</u> of <u>Bay St. Louis</u>	<u>Grey sand</u>		<u>173</u>
(distance) (direction) (Nearest Town)			
(3) Topography: <u>Flat</u>			
(Hilly) (Flat) (Level)			
(4) Purpose of Well: <u>Domestic home</u>			
(Domestic Irrigation Municipal, Industrial, Other)			

Information upon completion of well:

- (1) Diameter 2 inches. 4" Drilled
- (2) Total Depth 173 feet.
- (3) Water Level 0 feet below top of ground.
- (4) Cased to 168', Size 2"
- (5) Screen: Size 012, Length 5'
- (6) Were any formations sealed against pollution?
 yes, no.

If YES depth of formation _____
 Why _____

Drillers Remarks: Pumped with air at 800 GPM for cleaning only - Hand Pump installed

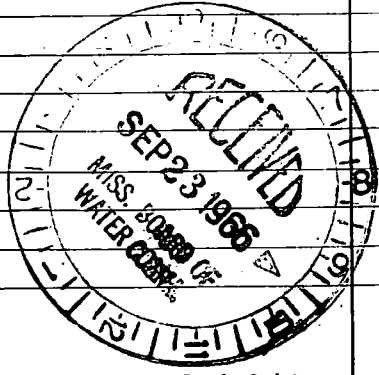

(Use Back Side)

Well No.

