

Hancock

K2144

9-66

MISSISSIPPI BOARD OF WATER COMMISSIONERS

WATER WELL DRILLERS LOG

Date: 9-8, 1966, Driller: Sutter Well Works County Hancock


(1) Owner of Land: James Ryan Jr.
2118 Carnot St. New Orleans La.
(2) Location: NE 1/4, NE 1/4, Sec. 40 T8SR14W
5 miles NW of Bay St Louis
(3) Topography: flat
(4) Purpose of Well: domestic home


Table with 3 columns: Description & Color of Materials, Thickness Feet, Depth Feet. Contains handwritten entries for clay and sand layers.

Information upon completion of well:

(1) Diameter 2 inches.
(2) Total Depth 152 feet.
(3) Water Level 147 feet below top of ground.
(4) Cased to 147, Size 2"
(5) Screen: Size 2", Length 5'
(6) Were any formations sealed against pollution? yes

If YES depth of formation surface
Why
Drillers Remarks:
Yield in gpm: 10
Size pump: unknown
Type power:

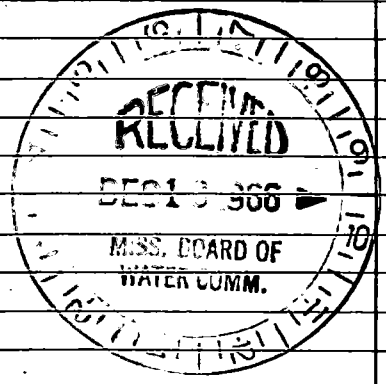

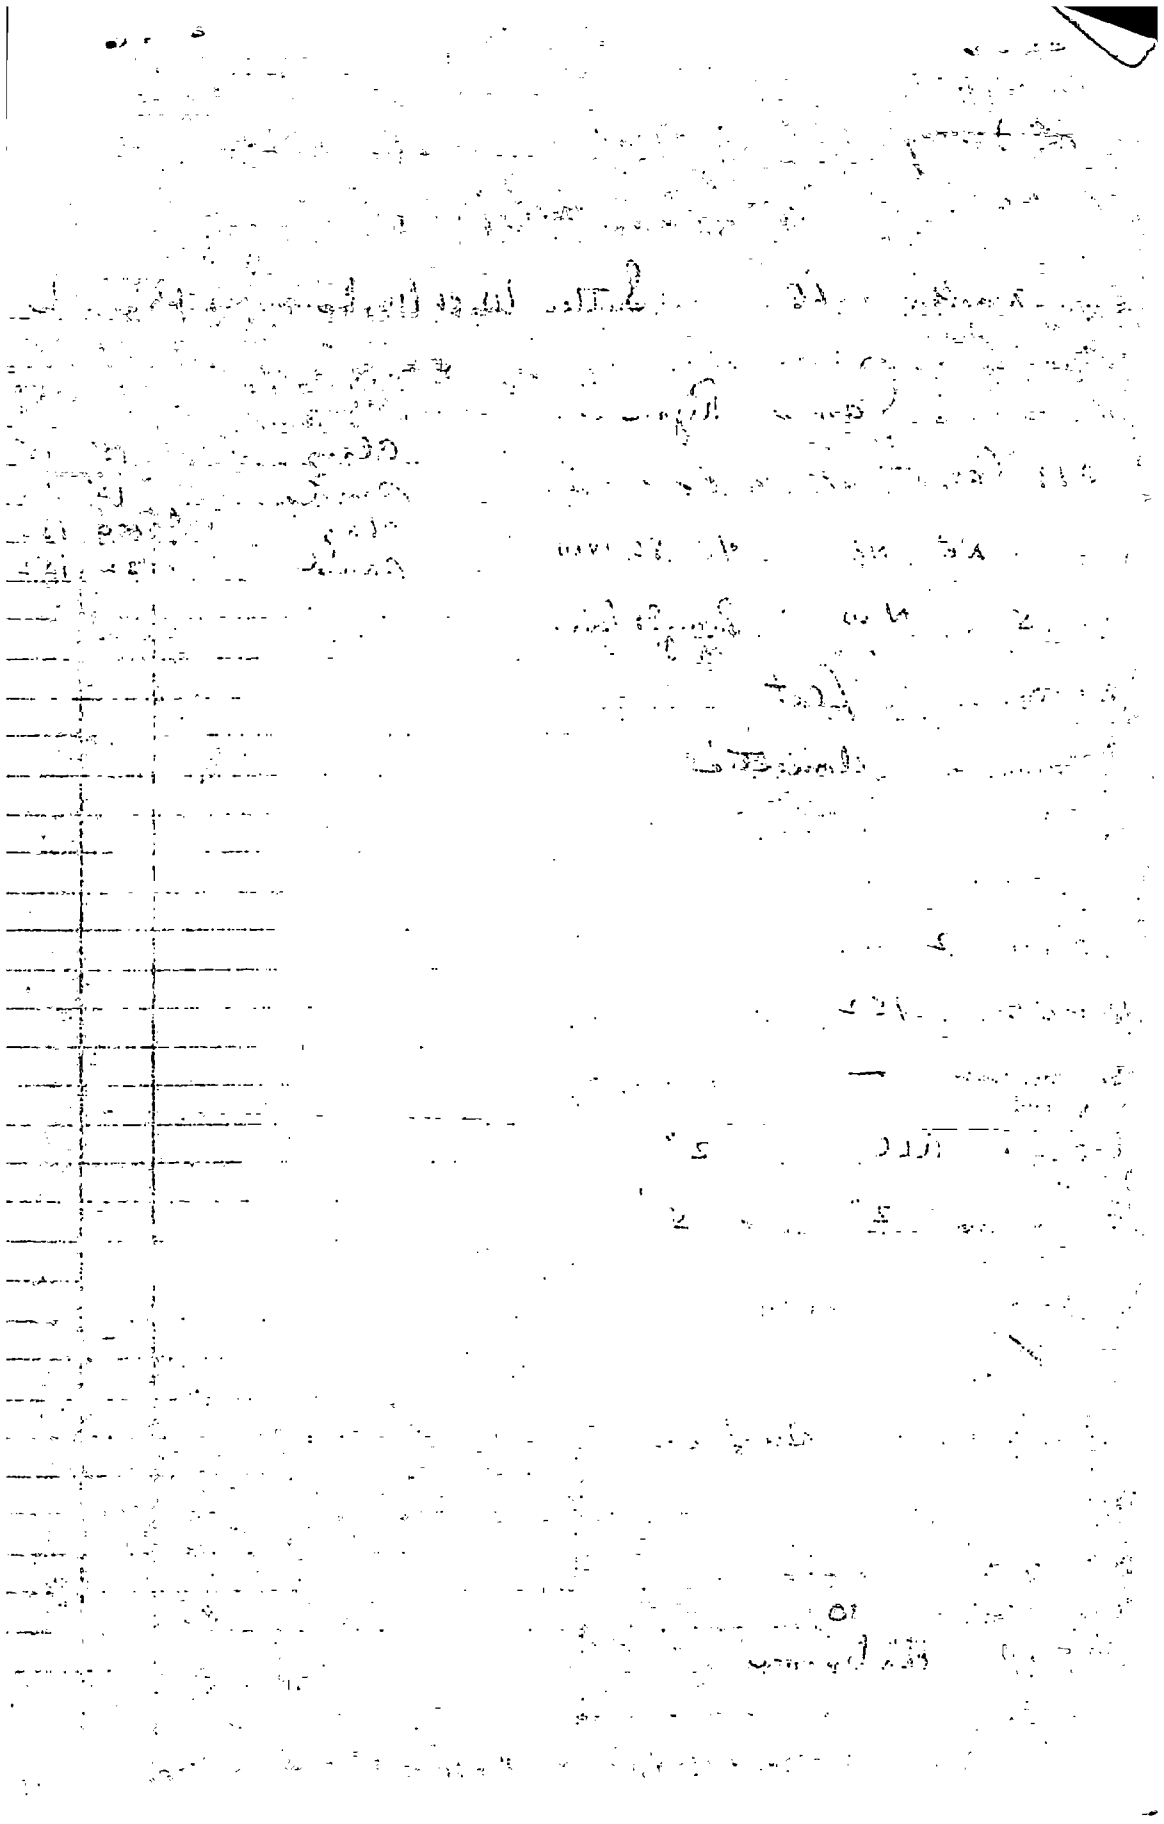

Faint, illegible text at the top left of the page, possibly a header or title.

Faint, illegible text in the upper right quadrant of the page.

A vertical grid structure on the left side of the page, consisting of multiple horizontal lines and a few vertical lines, forming a table-like structure.

Faint, illegible text in the middle right section of the page.

Faint, illegible text at the bottom right of the page.