

Hancock

MISSISSIPPI BOARD OF WATER COMMISSIONERS

K 2146

10-66

WATER WELL DRILLERS LOG

Date: 10-20, 1966, Driller: Walter Denton County Hancock

(Name)

(1) Owner of Land: H. C. Seal sr
 402 N. ^(Name) Hugh Ave
Picayune, Miss
 (Address)

(2) Location: SE 1/4, NW 1/4, Sec. 40 T8 R14
4 miles NW of Bryst Louis
 (distance) (direction) (Nearest Town)

(3) Topography: Flat
 (Hilly) (Flat) (Level)

(4) Purpose of Well: Domestic Home
 (Domestic Irrigation
 Municipal, Industrial, Other)

Description & Color of Materials Sand, Clay, Red Clay, Shell, etc.	Thick- ness Feet	Depth Feet
<u>yellow clay</u>	<u>20</u>	<u>0-20</u>
<u>white sand</u>	<u>28</u>	<u>48</u>
<u>Blue clay</u>	<u>88</u>	<u>136</u>
<u>" mud</u>	<u>43</u>	<u>179</u>
<u>Grey sand</u>		<u>205</u>

Information upon completion of well:

(1) Diameter 2 inches.

(2) Total Depth 205 feet.

(3) Water Level 2 feet ^{above} ~~below~~ top of ground.

(4) Cased to 200', Size 2"

(5) Screen: Size 2", Length 5'

(6) Were any formations sealed against pollution?
 _____ yes, _____ no.


IF sec. 19, 8^s, 14^w IS a
Full sec. This would
be in the

SE 1/4 - SE 1/4 - Sec. 19, T8, R14^s

If YES depth of formation _____

Why _____

Drillers Remarks: _____

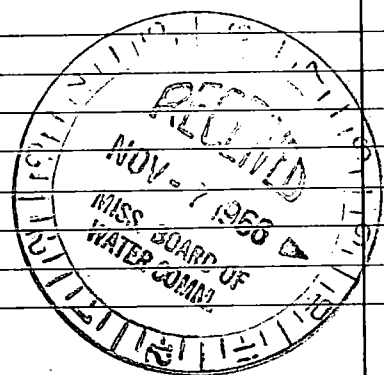

(Use Back Side)

Well No.

