

Hancock

MISSISSIPPI BOARD OF WATER COMMISSIONERS

R 2147

12-66

WATER WELL DRILLERS LOG

Date: 12-8, 1966, Driller: Walter Penford County Hancock

(Name)

(1) Owner of Land: Milford DENNISS
 (Name) MISS.
Gen. Del- Bay St. Louis
 (Address)

(2) Location: NW 1/4, S.E. 1/4, Sec. 33 T8 R14
0 miles West of Bay St. Louis
 (distance) (direction) (Nearest Town)

(3) Topography: Flat
 (Hilly) (Flat) (Level)

(4) Purpose of Well: Domestic Home
 (Domestic Irrigation
 Municipal, Industrial, Other)

Description & Color of Materials Sand, Clay, Red Clay, Shell, etc.	Thick- ness Feet	Depth Feet
Surface Sand	12	0-12
Brown sand	16	28
Mud	8	36
Brown clay	6	42
Blue clay	40	82
Sand	18	100
Blue clay	46	146
Sand + Gravel		173


Information upon completion of well:

- (1) Diameter 4 1/2 inches. Drilled
- (2) Total Depth 173 feet.
- (3) Water Level 6 feet below top of ground.
- (4) Cased to 168, Size 2"
- (5) Screen: Size 10-2", Length 5'
- (6) Were any formations sealed against pollution?
 yes, no.

If YES depth of formation _____

Why _____

Drillers Remarks: Did not cut to bottom of sand

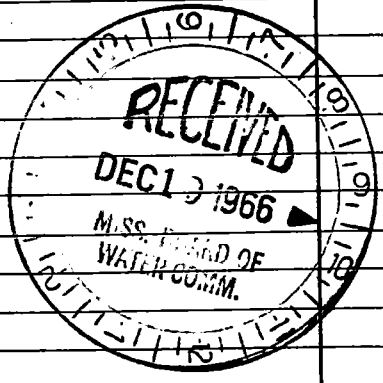

(Use Back Side)

Well No.

