

**MISSISSIPPI
BOARD OF WATER COMMISSIONERS**
416 North State Street
Jackson, Mississippi 39201

WATER WELL DRILLERS LOG

Hancock
K 2149
1-67

1-30 1967 Sutter Well Works Hancock
date well completed firm name county well located

LANDOWNER: Paccacio
40 DANTAGNAN REALTY
BAY ST. LOUIS, MISS.
(mailing address)

description of formations encountered	from	to
	<u>CLAY</u>	<u>0</u>
<u>SAND</u>	<u>90</u>	<u>107</u>

WELL LOCATION:
sec. 30 T. 8 S. R. 14 W.
5 miles NW of WAVELAND
(distance) (direction) (nearest town)

WELL PURPOSE: Home
(home, irrigation, municipal, industrial)


WELL COMPLETION DATA:

- (1) diameter (inches) 2
- (2) total depth (feet) 107
- (3) static water level (feet) 2 below above top of ground.
- (4) casing GALV., 102'
(material) (depth)
2" If telescope see back.
(size)
- (5) screen 5', 102'
(length) (depth to top)
2", STAINLESS STEEL
(size) (material)
- (6) pump 1/2, 15
(HP) (yield gpm)
ELEC
(type power)
- (7) electric log No
(yes or no)

(organization running log)

(8) how well bottom plugged B.P. VALUE

DRILLERS REMARKS:

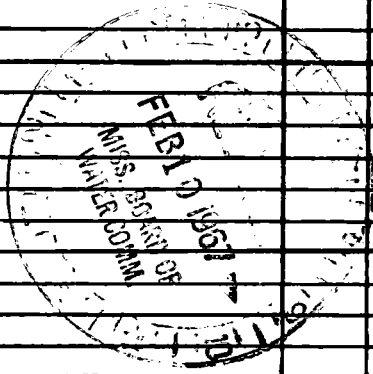

If well telescopes please sketch and show depths.

GROUND LEVEL



X			

SECTION 30

Please indicate well location X.

ADDITIONAL INFORMATION

If more than one screen, show locations of each on sketch.